

STATE ENGINEER
Salem, Oregon

LINN
6686

Well Record

STATE WELL NO. 11/2W-15K
COUNTY LINN
APPLICATION NO. GR-2455

OWNER: Swander Brothers


MAILING ADDRESS: Rt. 2, Box 234

LOCATION OF WELL: Owner's No. #2

CITY AND STATE: Lebanon, Oregon

NW ¼ SE ¼ Sec. 15 T. 11 S., R. 2 W., W.M.

Bearing and distance from section or subdivision corner 2277' N. and 1749' W.

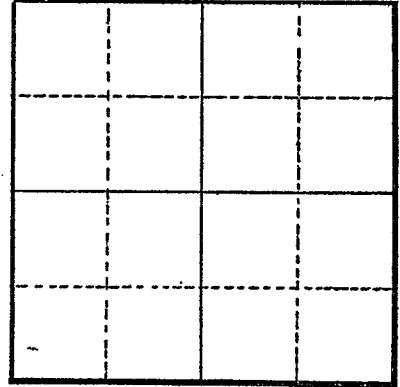

Section

Altitude at well

TYPE OF WELL: Drilled Date Constructed 1952

Depth drilled 21 Depth cased 22

CASING RECORD:

8-inch

FINISH:

Slot perforations from 16 to 22

AQUIFERS:

Sand, clay and gravel

WATER LEVEL:

11-feet

PUMPING EQUIPMENT: Type Pacific 2½" Centrifugal H.P. 16
Capacity G.P.M.

WELL TESTS:

Drawdown 1 ft. after hours Pumping 350 G.P.M.
Drawdown ft. after hours G.P.M.

USE OF WATER Irrigation Temp. °F., 19.....

SOURCE OF INFORMATION GR-2326

DRILLER or DIGGER Bill Hamilton Drilling Company, Albany, Oregon

ADDITIONAL DATA:

Log Water Level Measurements Chemical Analysis Aquifer Test

REMARKS:

Sandy 5 5
Clay and sand 7 12
Water Gravel 9 21