

STATE ENGINEER
Salem, Oregon

LINN
6688

Well Record

STATE WELL NO. 11/2W-15L(1)
COUNTY Linn
APPLICATION NO. GR-449

OWNER: Elmer & Jennie Perry


MAILING ADDRESS: Rt. 1, Box 311

LOCATION OF WELL: Owner's No.

CITY AND STATE: Albany, Oregon

NE 1/4 SW 1/4 Sec. 15 T. 11 N. S., R. 2 E. W., W.M.

Bearing and distance from section or subdivision
corner N. 40° 45' E. 25.5 chs. from NE cor. Henry
V. Clymer DLC 50

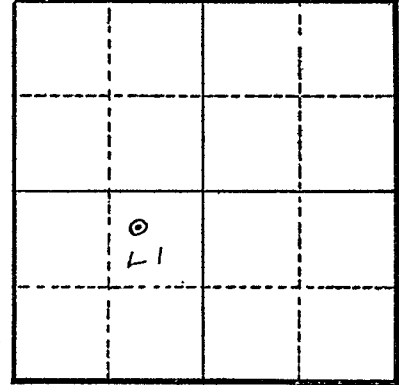

Section 15

Altitude at well 280 ft.

TYPE OF WELL: drilled Date Constructed 10/12/48

Depth drilled 27 ft. Depth cased 27 ft.

CASING RECORD: 10 inch

FINISH:

AQUIFERS:

WATER LEVEL: 9 ft.

PUMPING EQUIPMENT: Type Jacuzzi centrifugal H.P. 7 1/2
Capacity 200 G.P.M.

WELL TESTS:
Drawdown 8 ft. after 1500 hours G.P.M.
Drawdown ft. after hours G.P.M.

USE OF WATER irrigation 4.1 acres Temp. °F., 19

SOURCE OF INFORMATION GR-449

DRILLER or DIGGER

ADDITIONAL DATA:

Log Water Level Measurements Chemical Analysis Aquifer Test

REMARKS: