

STATE ENGINEER  
Salem, Oregon

LINN  
6689

# Well Record

GR- 1524


STATE WELL NO. 11/2W-15L  
COUNTY Linn  
APPLICATION NO. GR-1503

OWNER: Gale Burkhart  
MAILING ADDRESS: Rt. 2, Box 232

LOCATION OF WELL: Owner's No. #2  
CITY AND STATE: Lebanon, Oregon

NE 1/4 SW 1/4 Sec. 15 T. 11 S., R. 2 W., W.M.

Bearing and distance from section or subdivision  
corner N. 52°40' E. 35.75 ch. from SW cor. Sec. 15

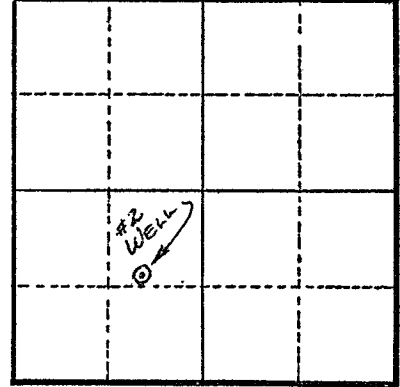

Section 15

Altitude at well 285'

TYPE OF WELL: Drilled Date Constructed 1955

Depth drilled 20' Depth cased 20'

CASING RECORD:  
10"

FINISH:  
Slot perforations from 14 to 20 ft.

AQUIFERS:

WATER LEVEL:  
12'

PUMPING EQUIPMENT: Type 2" Cent. H.P. Gas  
Capacity 300 G.P.M.

WELL TESTS:  
Drawdown 3 ft. after hours 600 G.P.M.  
Drawdown ft. after hours G.P.M.

USE OF WATER Irrigation Temp. °F., 19

SOURCE OF INFORMATION GR Record

DRILLER or DIGGER Bill Hamilton Drilling Co.

ADDITIONAL DATA:  
Log N.A. Water Level Measurements Chemical Analysis Aquifer Test

REMARKS:  
Irrigation of 59.5 acres.