

STATE ENGINEER  
Salem, Oregon

LINN  
6691

# Well Record


STATE WELL NO. 11/2W-150  
COUNTY LINN  
APPLICATION NO. GR-2614

OWNER: J. R. and Vada H. Peterson MAILING ADDRESS: Rt. 2, Box 278,

LOCATION OF WELL: Owner's No. \_\_\_\_\_ CITY AND STATE: Lebanon, Oregon

SW 1/4 SE 1/4 Sec. 15 T. 11 S., R. 2 W., W.M.

Bearing and distance from section or subdivision corner N. 62° 52' E. 13.8 chains

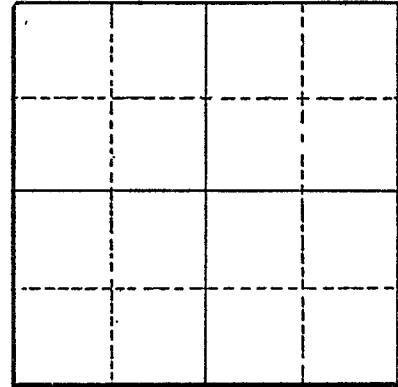

Section \_\_\_\_\_

Altitude at well \_\_\_\_\_

TYPE OF WELL: Drilled Date Constructed 1951

Depth drilled 22 Depth cased 20

### CASING RECORD:

10-inch

### FINISH:

Slot perforations from 15 to 20

### AQUIFERS:

### WATER LEVEL:

10-feet

PUMPING EQUIPMENT: Type Fairbanks Morse 1" Centrifugal H.P. 5  
Capacity 125 G.P.M.

### WELL TESTS:

Drawdown \_\_\_\_\_ ft. after \_\_\_\_\_ hours \_\_\_\_\_ G.P.M.  
Drawdown \_\_\_\_\_ ft. after \_\_\_\_\_ hours \_\_\_\_\_ G.P.M.

USE OF WATER Irrigation Temp. \_\_\_\_\_ °F. \_\_\_\_\_, 19\_\_\_\_

SOURCE OF INFORMATION GR-2481

DRILLER or DIGGER Bill Hamilton Drilling Co., 838 E. Third Ave., Albany, Oregon

### ADDITIONAL DATA:

Log \_\_\_\_\_ Water Level Measurements \_\_\_\_\_ Chemical Analysis \_\_\_\_\_ Aquifer Test \_\_\_\_\_

### REMARKS: