

STATE ENGINEER
Salem, Oregon

LIAN
6692

Well Record


GR-1008

STATE WELL NO. 11/2W-150(1)
COUNTY Linn
APPLICATION NO. GR-1046

OWNER: Vivian Frearksen MAILING ADDRESS: Rt. 3

LOCATION OF WELL: Owner's No. CITY AND STATE: Albany, Oregon

SW 1/4 SE 1/4 Sec. 15 T. 11 S., R. 2 W., W.M.
Bearing and distance from section or subdivision
corner N73°15'E. 20.75 ch. from S 1/4 cor. Sec. 15.

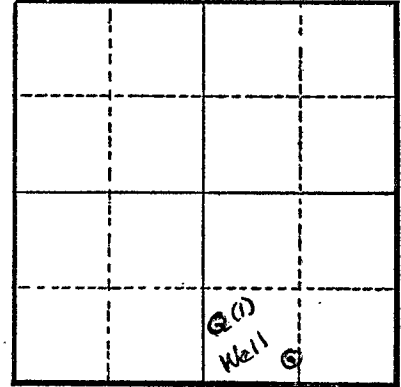

Section 15

Altitude at well 215 ft.

TYPE OF WELL: Drilled Date Constructed 1952

Depth drilled 48 ft. Depth cased 48 ft.

CASING RECORD:

8 inch

FINISH:

Slot perforations from 40 to 48 ft.

AQUIFERS:

WATER LEVEL:

12 ft.

PUMPING EQUIPMENT: Type Fairbanks Morse Deep Well H.P. 5
Capacity 100 G.P.M.

WELL TESTS:

Drawdown _____ ft. after _____ hours _____ G.P.M.

Drawdown _____ ft. after _____ hours _____ G.P.M.

USE OF WATER Irrigation Temp. _____ °F., 19 _____

SOURCE OF INFORMATION G. R. Record

DRILLER or DIGGER Wm. Shaffer

ADDITIONAL DATA:

Log N.A. Water Level Measurements _____ Chemical Analysis _____ Aquifer Test _____

REMARKS:

Irrigation of 22.6 acres.