

LINN
6693


Well Record

OWNER: Loren W. and Helen J. Blacklaw
MAILING ADDRESS: Route 2, Box 205

LOCATION OF WELL: Owner's No. Well #3
CITY AND STATE: Lebanon, Oregon

SE 1/4 SE 1/4 Sec. 15 T. 11 N. S., R. 2 E. W., W.M.

Bearing and distance from section or subdivision corner N. 42° 55' W. 9.3 chains from SE Corn.

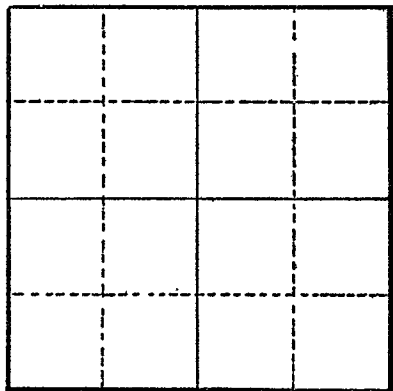

Section

Altitude at well

TYPE OF WELL: drilled Date Constructed 1949

Depth drilled 25' Depth cased 25'

CASING RECORD:
8"

FINISH:
slot perforations from 19 to 25

AQUIFERS:

WATER LEVEL:
16'

PUMPING EQUIPMENT: Type Fairbanks Morse 3" Cent. H.P. 15
Capacity 300 G.P.M.

WELL TESTS:
Drawdown 5 ft. after hours pumping 400 G.P.M.
Drawdown ft. after hours G.P.M.

USE OF WATER Irrigation Temp. °F., 19

SOURCE OF INFORMATION GR-3164
DRILLER or DIGGER A. C. Rucker, Lebanon, Oregon

ADDITIONAL DATA:
Log Water Level Measurements Chemical Analysis Aquifer Test

REMARKS:
WKC - J. A. Rucker not A.C.