

STATE ENGINEER
Salem, Oregon

LINN
6709

Well Record


STATE WELL NO. 11/2W-16J
COUNTY Linn
APPLICATION NO. GR-3212

OWNER: Webber Doughton MAILING ADDRESS: Route 1, Box 326

LOCATION OF WELL: Owner's No. 2 CITY AND STATE: Albany, Oregon

NE 1/4 SE 1/4 Sec. 16 T. 11 S., R. 2 W., W.M.

Bearing and distance from section or subdivision corner 2838' S. and 1254' W. of N.E. corner of Sec. 16

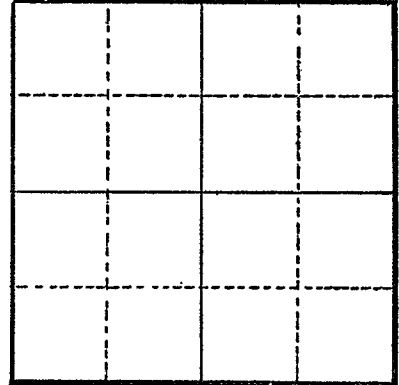

Section 35

Altitude at well _____

TYPE OF WELL: drilled Date Constructed 1954

Depth drilled 35 Depth cased 35

CASING RECORD:

6 inch

FINISH:

Slot perforations from 32 to 35

AQUIFERS:

WATER LEVEL:

12 feet

PUMPING EQUIPMENT: Type Gould Centrifugal H.P. 20
Capacity 500 G.P.M.

WELL TESTS:

Drawdown 13 ft. after _____ hours Pumping 300 G.P.M.

Drawdown _____ ft. after _____ hours _____ G.P.M.

USE OF WATER Irrigation Temp. _____ °F. _____, 19____

SOURCE OF INFORMATION GR-2989

DRILLER or DIGGER Bill Hamilton Drilling Co., 838 E. Third Ave, Albany

ADDITIONAL DATA:

Log _____ Water Level Measurements _____ Chemical Analysis _____ Aquifer Test _____

REMARKS: