

STATE ENGINEER
Salem, Oregon

LINN
6713

Well Record

STATE WELL NO. 11/2W-17R
COUNTY Linn
APPLICATION NO. GR-1595

GR- 1543

OWNER: Fred V. Kropf


MAILING ADDRESS: Rt. 1, Box 330

LOCATION OF WELL: Owner's No. _____

CITY AND STATE: Albany, Oregon

SE 1/4 SE 1/4 Sec. 17 T. 11 S., R. 2 W., W.M.

Bearing and distance from section or subdivision
corner N. 85° W. 9.5 ch. from SE cor. Sec. 17

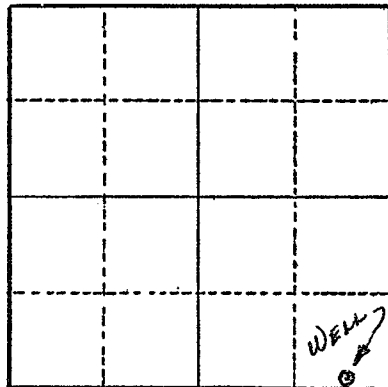

Section 17

Altitude at well 280'

TYPE OF WELL: Drilled Date Constructed 1951

Depth drilled 97' Depth cased 97'

CASING RECORD:

8"

FINISH:

Slot Perforations: 20 to 25 ft.
 26 to 31 ft.
 41 to 56 ft. 61 to 94 ft.

AQUIFERS:

WATER LEVEL:

8'

PUMPING EQUIPMENT: Type Pacific deep well turbine H.P. 5
Capacity 150 G.P.M.

WELL TESTS:

Drawdown 45 ft. after _____ hours 110 G.P.M.
Drawdown _____ ft. after _____ hours _____ G.P.M.

USE OF WATER Irrigation Temp. _____ °F., 19 _____

SOURCE OF INFORMATION GR Record

DRILLER or DIGGER _____

ADDITIONAL DATA:

Log _____ Water Level Measurements _____ Chemical Analysis _____ Aquifer Test _____

REMARKS:

Log: Clay 0 to 6 ft.
 Hardpan & gravel 6 to 23 ft.
 Loose gravel 23 to 25 ft.
 Gravel 25 to 31 ft.
 Brown clay 31 to 41 ft.
 Gravel & sand 41 to 56 ft.
 Gray clay 56 to 61 ft.
 Gravel & sand 61 to 95 ft.
 Rotten wood & clay 95 to 100 ft.
Irrigation of 5.4 acres.