

STATE ENGINEER  
Salem, Oregon

LINN  
6724

# Well Record

GR- 1615

STATE WELL NO. 11/2W-18L  
COUNTY Linn  
APPLICATION NO. GR- 1664

OWNER: Marvin E. Glaser


MAILING ADDRESS: Rt. 1, Box 332

LOCATION OF WELL: Owner's No. \_\_\_\_\_

CITY AND STATE: Albany, Oregon

NE ¼ SW ¼ Sec. 18 T. 11 S., R. 2 W., W.M.

Bearing and distance from section or subdivision  
corner 2838' S. & 2772' W. from NE cor. Sec. 18

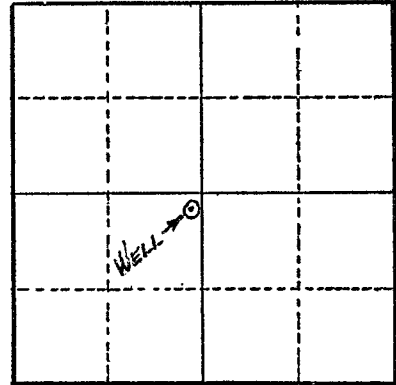

Section 18

Altitude at well 300'

TYPE OF WELL: Drilled Date Constructed 1952

Depth drilled 105' Depth cased 105'

### CASING RECORD:

8"

### FINISH:

Slot perforations from 80 to 105 ft.

### AQUIFERS:

### WATER LEVEL:

15'

PUMPING EQUIPMENT: Type F. M. Deep Well Turbine H.P. 15  
Capacity 300 G.P.M.

### WELL TESTS:

Drawdown 55 ft. after \_\_\_\_\_ hours 260 G.P.M.  
Drawdown \_\_\_\_\_ ft. after \_\_\_\_\_ hours \_\_\_\_\_ G.P.M.

USE OF WATER Irrigation Temp. \_\_\_\_\_ °F. \_\_\_\_\_, 19\_\_\_\_

SOURCE OF INFORMATION GR Record

DRILLER or DIGGER Marion West

### ADDITIONAL DATA:

Log N.A. Water Level Measurements \_\_\_\_\_ Chemical Analysis \_\_\_\_\_ Aquifer Test \_\_\_\_\_

### REMARKS:

Irrigation of 38 acres.