


File Original and First Copy with the STATE ENGINEER, SALEM, OREGON

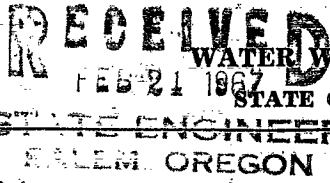

2 INN  
6748

State Well No. 11/26-20L  
State Permit No. G-3740

(1) OWNER:

Name F. J. Warman  
Address Rt. 2, Box 248, Lebanon

(2) LOCATION OF WELL:

County LINN Owner's number, if any—  
NE 1/4 SW 1/4 Section 20 T. 11S R. 2W W.M.  
Bearing and distance from section or subdivision corner  
N. 46° E. 31.5 CHAINS FROM SW CORNER S. 20, T. 11S., R. 2W

(3) TYPE OF WORK (check):

New Well  Deepening  Reconditioning  Abandon   
If abandonment, describe material and procedure in Item 11.

(4) PROPOSED USE (check):

Domestic  Industrial  Municipal   
Irrigation  Test Well  Other

(5) TYPE OF WELL:

Rotary  Driven   
Cable  Jettied   
Dug  Bored

(6) CASING INSTALLED:

Threaded  Welded   
6 " Diam. from 0.0 ft. to 53-2 ft. Gage 280  
" Diam. from \_\_\_\_\_ ft. to \_\_\_\_\_ ft. Gage \_\_\_\_\_  
" Diam. from \_\_\_\_\_ ft. to \_\_\_\_\_ ft. Gage \_\_\_\_\_

(7) PERFORATIONS:

Perforated?  Yes  No  
Type of perforator used \_\_\_\_\_  
SIZE of perforations in. by in.  
perforations from \_\_\_\_\_ ft. to \_\_\_\_\_ ft.  
perforations from \_\_\_\_\_ ft. to \_\_\_\_\_ ft.  
(8) SCREENS:

Well screen installed  Yes  No  
Manufacturer's Name \_\_\_\_\_  
Type \_\_\_\_\_ Model No. \_\_\_\_\_  
Diam. \_\_\_\_\_ Slot size \_\_\_\_\_ Set from \_\_\_\_\_ ft. to \_\_\_\_\_ ft.  
Diam. \_\_\_\_\_ Slot size \_\_\_\_\_ Set from \_\_\_\_\_ ft. to \_\_\_\_\_ ft.

(9) CONSTRUCTION:

Was well gravel packed?  Yes  No Size of gravel: \_\_\_\_\_  
Gravel placed from \_\_\_\_\_ ft. to \_\_\_\_\_ ft.  
Was a surface seal provided?  Yes  No To what depth? \_\_\_\_\_ ft.  
Material used in seal—  
Did any strata contain unusable water?  Yes  No  
Type of water? \_\_\_\_\_ Depth of strata \_\_\_\_\_  
Method of sealing strata off \_\_\_\_\_

(10) WATER LEVELS:

Static level 7 ft. below land surface Date \_\_\_\_\_  
Artesian pressure \_\_\_\_\_ lbs. per square inch Date 7/1/59

Log Accepted by: \_\_\_\_\_  
[Signed] \_\_\_\_\_ Date \_\_\_\_\_, 19\_\_\_\_  
(Owner)

(11) WELL TESTS:

Drawdown is amount water level is lowered below static level  
Was a pump test made?  Yes  No If yes, by whom?  
Yield: 50 gal./min. with 33 ft. drawdown after \_\_\_\_\_ hrs.  
" " " " "  
" " " " "  
Bailer test 50 gal./min. with 33 ft. drawdown after 1/2 hrs.  
Artesian flow \_\_\_\_\_ g.p.m. Date \_\_\_\_\_  
Temperature of water \_\_\_\_\_ Was a chemical analysis made?  Yes  No

(12) WELL LOG:

Diameter of well \_\_\_\_\_ inches.  
Depth drilled 57 ft. Depth of completed well 57 ft.  
Formation: Describe by color, character, size of material and structure, and show thickness of aquifers and the kind and nature of the material in each stratum penetrated, with at least one entry for each change of formation.

MATERIAL	FROM	TO
Soil Rock & Gravel	00	11
Fine Gravel Sand	11	22
Sand	22	23
Fine Gravel Sand	23	39
Sand	39	40
Fine Gravel Sand	40	50
Hard Sand	50	57
Fine Loose Sand	52	57

Work started June 21 19 59 Completed July 1 19 59

(13) PUMP:

Manufacturer's Name \_\_\_\_\_  
Type: \_\_\_\_\_ H.P. \_\_\_\_\_

Well Driller's Statement:

This well was drilled under my jurisdiction and this report is true to the best of my knowledge and belief.

NAME J. A. Pucker  
(Person, firm, or corporation) (Type or print)

Address 661 Grove St Lebanon

Driller's well number \_\_\_\_\_

[Signed] J. A. Pucker  
(Well Driller)

License No. 93 Date July 1, 19 59