

STATE ENGINEER
Salem, Oregon

LINN
6760

Well Record

STATE WELL NO. 11/2W-21H
COUNTY Linn
APPLICATION NO. GR-2115

OWNER: W. E. Barker


MAILING ADDRESS: Rt. 2, Box 227C

LOCATION OF WELL: Owner's No. 2

CITY AND STATE: Albany, Oregon

SE 1/4 NE 1/4 Sec. 21 T. 11 N. S. R. 2 E. W., W.M.

Bearing and distance from section or subdivision corner 500' N. & 760' W.

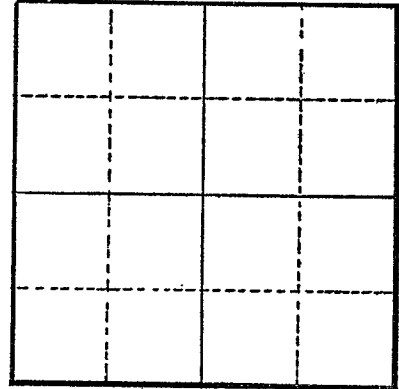

Section

Altitude at well

TYPE OF WELL: drilled Date Constructed 1952

Depth drilled 40 ft. Depth cased 40 ft.

CASING RECORD: 6 inch

FINISH: Perforations from 20 to 40 ft.

AQUIFERS:

WATER LEVEL: 3.5 ft.

PUMPING EQUIPMENT: Type Fairbanks Morse centrifugal H.P. 10
Capacity 150 G.P.M.

WELL TESTS:

Drawdown ft. after hours G.P.M.

Drawdown ft. after hours G.P.M.

USE OF WATER irrigation Temp. °F. 19

SOURCE OF INFORMATION GR-2033

DRILLER or DIGGER

ADDITIONAL DATA:

Log Water Level Measurements Chemical Analysis Aquifer Test

REMARKS: