

STATE ENGINEER
Salem, Oregon

LINN
6762

Well Record


STATE WELL NO. 11/2W-21J
COUNTY LINN
APPLICATION NO. GR-2856

OWNER: Santiam Valley Nurseries
MAILING ADDRESS: Rt. 2, Box 226

LOCATION OF WELL: Owner's No. _____
CITY AND STATE: Lebanon, Oregon

NE 1/4 SE 1/4 Sec. 21 T. 11 N. S, R. 2 E. W., W.M.

Bearing and distance from section or subdivision
corner 1914' N. and 957' W.

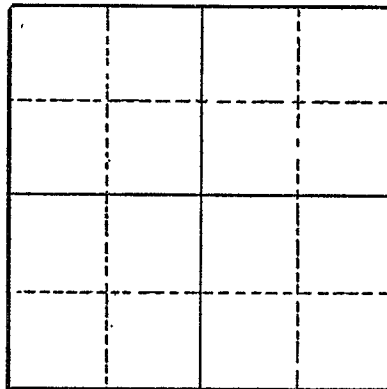

Section

Altitude at well _____

TYPE OF WELL: drilled. Date Constructed 1944

Depth drilled 30 Depth cased 30

CASING RECORD:

8-inch

FINISH:

Slot perforations from 18 to 30

AQUIFERS:

WATER LEVEL:

9-feet

PUMPING EQUIPMENT: Type Fairbanks Morse Centrifugal H.P. 7 1/2
Capacity 200 G.P.M.

WELL TESTS:

Drawdown _____ ft. after _____ hours _____ G.P.M.

Drawdown _____ ft. after _____ hours _____ G.P.M.

USE OF WATER irrigation Temp. _____ °F. _____, 19

SOURCE OF INFORMATION GR-2690

DRILLER or DIGGER Dwight Glassey, Albany, Oregon

ADDITIONAL DATA:

Log _____ Water Level Measurements _____ Chemical Analysis _____ Aquifer Test _____

REMARKS: