

STATE ENGINEER
Salem, Oregon

LINN
6763

Well Record

STATE WELL NO. 11/2W-21J
COUNTY Linn
APPLICATION NO. GR-3785

OWNER: George Hannaford

MAILING ADDRESS: Route 2, Box 225


LOCATION OF WELL: Owner's No. _____

CITY AND STATE: Lebanon, Oregon

NE 1/4 SE 1/4 Sec. 21 T. 11 N. S., R. 2 E. W., W.M.

Bearing and distance from section or subdivision

corner 1386 ft. N. & 264 ft. W. of SE Cor., Sec. 21

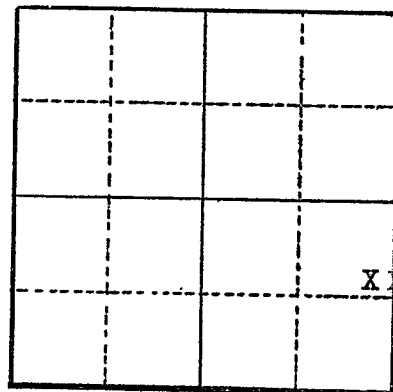

Section 21

Altitude at well _____

TYPE OF WELL: Dug Date Constructed May, 1955

Depth drilled 14 feet Depth cased _____

CASING RECORD:

FINISH:

AQUIFERS:

WATER LEVEL:

6 feet below surface

PUMPING EQUIPMENT: Type Berkley 4" centrifugal H.P. 15
Capacity 200 G.P.M.

WELL TESTS:

Drawdown _____ ft. after _____ hours _____ G.P.M.

Drawdown _____ ft. after _____ hours _____ G.P.M.

USE OF WATER Irrigation Temp. _____ °F. _____, 19____

SOURCE OF INFORMATION Well Registration Statement

DRILLER or DIGGER Don Goldson

ADDITIONAL DATA:

Log _____ Water Level Measurements _____ Chemical Analysis _____ Aquifer Test _____

REMARKS:

3446