

STATE ENGINEER  
Salem, Oregon

LINN  
6784

# Well Record

STATE WELL NO. 11/2W-22A(1)  
COUNTY Linn  
APPLICATION NO. GR-261

OWNER: Myrtle Donovan


MAILING ADDRESS: Rt. 2, Box 116

LOCATION OF WELL: Owner's No. 2

CITY AND STATE: Lebanon, Oregon

NE 1/4 NE 1/4 Sec. 22 T. 11 N. S., R. 2 E. W., W.M.

Bearing and distance from section or subdivision  
corner N. 9° W. 38 chs. from SE cor. Jonathan Wassom DLC 49

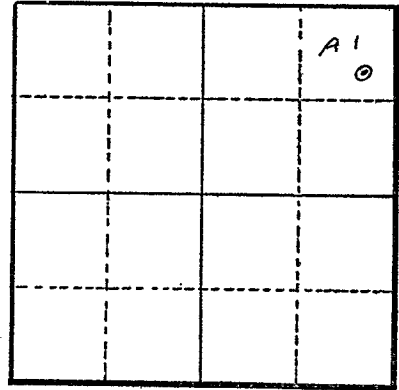

Section 22

Altitude at well 290 ft. Interpolated

TYPE OF WELL: drilled Date Constructed 5/1/52

Depth drilled 22 ft. Depth cased 22 ft.

CASING RECORD: 8 inch steel casing set between 0 and 22 ft.

FINISH: Slit perforations from 17 to 22 ft.

AQUIFERS: unknown

WATER LEVEL: 8 ft. below land surface

PUMPING EQUIPMENT: Type Fairbanks Morse 3" centrifugal H.P. 10  
Capacity 300 G.P.M.

WELL TESTS:  
Drawdown 1 ft. after \_\_\_\_\_ hours pumping 200 G.P.M.  
Drawdown \_\_\_\_\_ ft. after \_\_\_\_\_ hours \_\_\_\_\_ G.P.M.

USE OF WATER irrigation 16.7 acres Temp. \_\_\_\_\_ °F., 19

SOURCE OF INFORMATION Reg. St. GR-261

DRILLER or DIGGER Rob. E. White; 465 Wagon Wheel Dr., Lebanon, Oregon

ADDITIONAL DATA:

Log \_\_\_\_\_ Water Level Measurements \_\_\_\_\_ Chemical Analysis \_\_\_\_\_ Aquifer Test \_\_\_\_\_

REMARKS: