

STATE ENGINEER  
Salem, Oregon

LINN  
6785

# Well Record

GR- 1454

STATE WELL NO. 11/2W-22D  
COUNTY Linn  
APPLICATION NO. GR- 1502

OWNER: Gale Burkhart


MAILING ADDRESS: Rt. 2, Box 232

LOCATION OF WELL: Owner's No. #1

CITY AND STATE: Lebanon, Oregon

NW 1/4 NW 1/4 Sec. 22 T. 11 S., R. 2 W., W.M.

Bearing and distance from section or subdivision corner S. 84°40' E. 18.5 ch. from NW cor. Sec. 22.

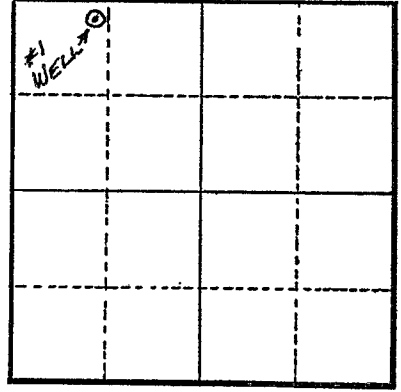

Section 22

Altitude at well 285'

TYPE OF WELL: Drilled Date Constructed 1954

Depth drilled 20' Depth cased 20'

CASING RECORD:  
10"

FINISH:  
Slot perforations from 10 to 20 ft.

AQUIFERS:

WATER LEVEL:  
12'

PUMPING EQUIPMENT: Type 2" Cent. H.P. 15  
Capacity 300 G.P.M.

WELL TESTS:  
Drawdown 3 ft. after \_\_\_\_\_ hours 600 G.P.M.  
Drawdown \_\_\_\_\_ ft. after \_\_\_\_\_ hours \_\_\_\_\_ G.P.M.

USE OF WATER Irrigation Temp. \_\_\_\_\_ °F. \_\_\_\_\_, 19\_\_\_\_

SOURCE OF INFORMATION GR Record

DRILLER or DIGGER Bill Hamilton

ADDITIONAL DATA:  
Log N.A. Water Level Measurements \_\_\_\_\_ Chemical Analysis \_\_\_\_\_ Aquifer Test \_\_\_\_\_

REMARKS:  
Irrigation of 84.6 acres.