

STATE ENGINEER
Salem, Oregon

LINN
6787

Well Record

STATE WELL NO. 11/2W-22H
COUNTY LINN
APPLICATION NO. GR-2454

OWNER: Swander Brothers

MAILING ADDRESS: Rt. 2, Box 234,


LOCATION OF WELL: Owner's No. #1

CITY AND STATE: Lebanon, Oregon

SE 1/4 NE 1/4 Sec. 22 T. 11 S., R. 2 W., W.M.

Bearing and distance from section or subdivision

corner 1650' S. and 1201' W.

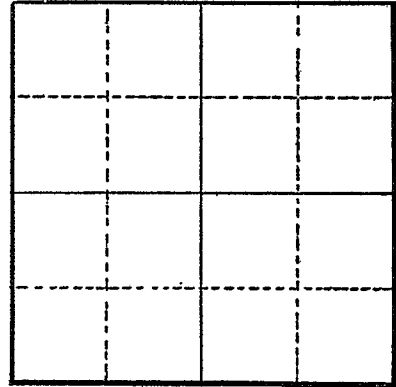

Section

Altitude at well

TYPE OF WELL: Drilled Date Constructed 1951

Depth drilled 21 Depth cased 20

CASING RECORD:

8-inch

FINISH:

Slot perforations from 14 to 20

AQUIFERS:

Soil, clay, sand and gravel

WATER LEVEL:

7-feet

PUMPING EQUIPMENT: Type Pacific Centrifugal H.P. 16
Capacity 200 G.P.M.

WELL TESTS:

Drawdown 1 ft. after hours Pumping 350 G.P.M.

Drawdown ft. after hours G.P.M.

USE OF WATER Irrigation Temp. °F., 19

SOURCE OF INFORMATION GR-2325

DRILLER or DIGGER Bill Hamilton Well Drilling Co., Albany, Oregon

ADDITIONAL DATA:

Log ^X Water Level Measurements Chemical Analysis Aquifer Test

REMARKS:

| | | |
|----------------------|---|----|
| Soil and clay | 7 | 7 |
| Gravel and blue clay | 7 | 14 |
| Gravel and sand | 7 | 21 |