

STATE ENGINEER
Salem, Oregon

LINN
6788

Well Record

STATE WELL NO. 11/2W-22H
COUNTY LINN
APPLICATION NO. GR-2456

OWNER: Swander Brothers


MAILING ADDRESS: Rt. 2, Box 234

LOCATION OF WELL: Owner's No. #3

CITY AND STATE: Lebanon, Oregon

SE 1/4 NE 1/4 Sec. 22 T. 11 N. S. R. 2 W., W.M.

Bearing and distance from section or subdivision corner 2112' S. and 1318' W.

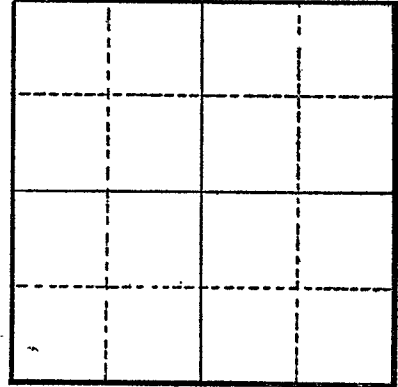

Section

Altitude at well

TYPE OF WELL: Drilled Date Constructed 1952

Depth drilled 21 Depth cased 20

CASING RECORD:

8-inch

FINISH:

Slot perforations from 14 to 20

AQUIFERS:

Loam, clay, gravel and sand

WATER LEVEL:

8-feet

PUMPING EQUIPMENT: Type Pacific 3" Centrifugal H.P. 16
Capacity G.P.M.

WELL TESTS:

Drawdown ft. after hours Pumping 350 G.P.M.

Drawdown ft. after hours G.P.M.

USE OF WATER Irrigation Temp. °F., 19

SOURCE OF INFORMATION GR-2327

DRILLER or DIGGER Bill Hamilton Well Drilling Co., Albany, Oregon

ADDITIONAL DATA:

Log Water Level Measurements Chemical Analysis Aquifer Test

REMARKS:

Sandy loam and clay with some gravel	0	8
Gravel and clay	8	11
Sand and gravel	11	21