

STATE ENGINEER
Salem, Oregon

LINN
6799

Well Record

STATE WELL NO. 11/2W-23E(1)
COUNTY Linn
APPLICATION NO. GR-415

OWNER: Edwin Neuschwander


MAILING ADDRESS: Rt. 2, Box 238

LOCATION OF WELL: Owner's No.

CITY AND STATE: Lebanon, Oregon

SW 1/4 NW 1/4 Sec. 23 T. 11 N. S. R. 2 W., W.M.

Bearing and distance from section or subdivision corner N. 19° 30' E. 17.5 chs. from SE cor. DLG 49

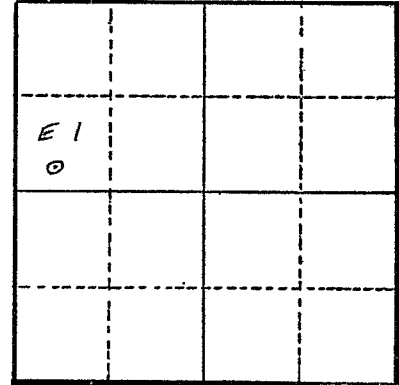

Section 23

Altitude at well 295 ft.

TYPE OF WELL: drilled Date Constructed 5/14/54

Depth drilled 20 ft. Depth cased 20 ft.

CASING RECORD: 10 inch

FINISH:

AQUIFERS:

WATER LEVEL: 10 ft.

PUMPING EQUIPMENT: Type Fairbanks Morse H.P. 27
Capacity 250 G.P.M.

WELL TESTS:

Drawdown ft. after hours G.P.M.

Drawdown ft. after hours G.P.M.

USE OF WATER irrigation 25.4 acres Temp. °F. 19

SOURCE OF INFORMATION GR-415

DRILLER or DIGGER Bill Hamilton Drilling Co.; Albany, Oregon

ADDITIONAL DATA:

Log Water Level Measurements Chemical Analysis Aquifer Test

REMARKS: