

STATE ENGINEER
Salem, Oregon

LINN
6800

Well Record

STATE WELL NO. 11/2W-23L(1)
COUNTY Linn
APPLICATION NO. GR-375

OWNER: Charles G. & Henry P. Lacer

MAILING ADDRESS:

Rt. 2, Box 241


LOCATION OF WELL: Owner's No. _____

CITY AND STATE:

Lebanon, Oregon

NE 1/4 SW 1/4 Sec. 23 T. 11 N. S. R. 2 W., W.M.

Bearing and distance from section or subdivision corner N. 4° 20' W. 33 chs. from SW cor. SE 1/4 Sec. 23

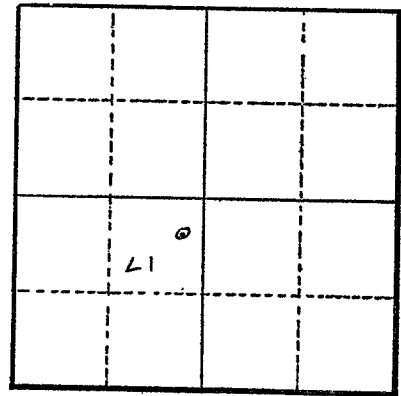

Section 23

Altitude at well 292 ft.

TYPE OF WELL: drilled Date Constructed 9/16/53

Depth drilled 25 ft. Depth cased 25 ft.

CASING RECORD: 8 inch

FINISH:

AQUIFERS:

WATER LEVEL: 12 ft.

PUMPING EQUIPMENT: Type Goulds 3" centrifugal H.P. 15
Capacity 300 G.P.M.

WELL TESTS:

Drawdown _____ ft. after _____ hours _____ G.P.M.
Drawdown _____ ft. after _____ hours _____ G.P.M.

USE OF WATER irrigation Temp. _____ °F. _____, 19____

SOURCE OF INFORMATION Ground Water Reg. Record

DRILLER or DIGGER _____

ADDITIONAL DATA:

Log _____ Water Level Measurements _____ Chemical Analysis _____ Aquifer Test _____

REMARKS: