

STATE ENGINEER  
Salem, Oregon

LINN  
6803

# Well Record

STATE WELL NO. 11/2W-23P(1)  
COUNTY Linn  
APPLICATION NO. GR-161

OWNER: Max, Elizabeth & Clara Burkhart

MAILING ADDRESS: Rt. 2, Box 216


LOCATION OF WELL: Owner's No. 1

CITY AND STATE: Lebanon, Oregon

SE 1/4 SW 1/4 Sec. 23 T. 11 N. S., R. 2 E. W., W.M.

Bearing and distance from section or subdivision corner 66.63 chs. N. 89° 57' E. from NW cor.

DLC 56

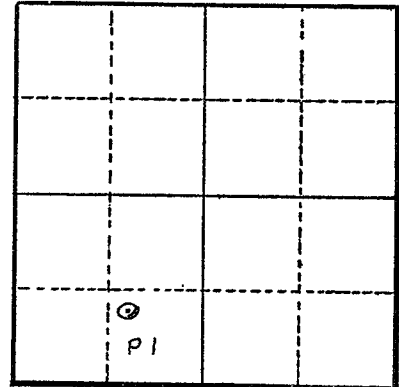

Section 23

Altitude at well 295 ft. Interpolated

TYPE OF WELL: drilled Date Constructed 5/10/50

Depth drilled 25 ft. Depth cased 25 ft.

CASING RECORD: 8 in. steel casing set from 0 to 25 ft.

FINISH: perforated 0 to 25 ft.

AQUIFERS: no record

WATER LEVEL: 10 ft. below land surface

PUMPING EQUIPMENT: Type Fairbanks Morse centrifugal 3" H.P. 15  
Capacity 600 G.P.M.

WELL TESTS:  
Drawdown 2 ft. after \_\_\_\_\_ hours pumping 700 G.P.M.  
Drawdown \_\_\_\_\_ ft. after \_\_\_\_\_ hours \_\_\_\_\_ G.P.M.

USE OF WATER irrigation 31 acres Temp. \_\_\_\_\_ °F., 19

SOURCE OF INFORMATION Reg. St. GR-161

DRILLER or DIGGER J. R. Rucker; Lebanon, Oregon

ADDITIONAL DATA:

Log \_\_\_\_\_ Water Level Measurements \_\_\_\_\_ Chemical Analysis \_\_\_\_\_ Aquifer Test \_\_\_\_\_

REMARKS: