

STATE ENGINEER
Salem, Oregon

LINN
6804

Well Record

STATE WELL NO. 11/2W-23P(2)
COUNTY Linn
APPLICATION NO. GR-321

OWNER: Luther R. & Roberta E. Shanks


MAILING ADDRESS: Rt. 2, Box 243

LOCATION OF WELL: Owner's No. 1

CITY AND STATE: Lebanon, Oregon

SE 1/4 SW 1/4 Sec. 23 T. 11 N. S. R. 2 E. W., W.M.

Bearing and distance from section or subdivision corner N. 56° 45' E. 59 chs. from NW cor. DLC 57

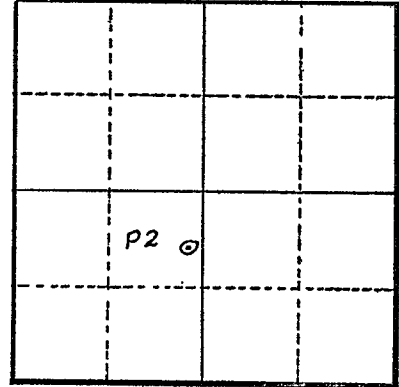

Section 23

Altitude at well 300 ft. Interpolated

TYPE OF WELL: drilled Date Constructed 8/7/54

Depth drilled 26 ft. Depth cased 26 ft.

CASING RECORD: 10 inch steel casing set from 0 to 26 ft.

FINISH: Slit perforations set from 20 to 26 ft.

AQUIFERS: unknown

WATER LEVEL: 11 ft. below land surface

PUMPING EQUIPMENT: Type Fairbanks Morse 1 1/2" centrifugal H.P. 7 1/2
Capacity 200 G.P.M.

WELL TESTS:

Drawdown 15 ft. after _____ hours pumping 250 G.P.M.

Drawdown _____ ft. after _____ hours _____ G.P.M.

USE OF WATER irrigation 19.6 acres Temp. _____ °F., 19

SOURCE OF INFORMATION Reg. St. GR-321

DRILLER or DIGGER Bill Hamilton; Albany, Oregon

ADDITIONAL DATA:

Log _____ Water Level Measurements _____ Chemical Analysis _____ Aquifer Test _____

REMARKS: