

STATE ENGINEER  
Salem, Oregon

LINN  
6805

# Well Record

STATE WELL NO. 11/2W-23Q(1)  
COUNTY Linn  
APPLICATION NO. GR-531

OWNER: Hiram & Sadie Gregson


MAILING ADDRESS: Rt. 2, Box 242

LOCATION OF WELL: Owner's No. 1

CITY AND STATE: Lebanon, Oregon

SW  $\frac{1}{4}$  SE  $\frac{1}{4}$  Sec. 23 T. 11 S., R. 2 W., W.M.

Bearing and distance from section or subdivision corner N. 53° 30' E. 21.25 chs. from SW cor. SE  $\frac{1}{4}$  Sec. 23

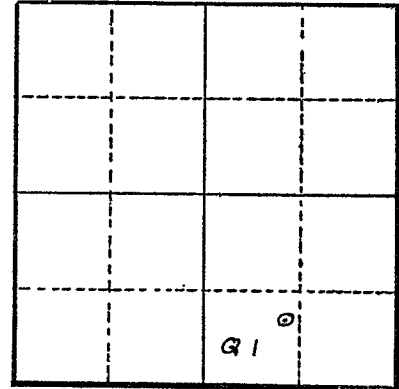

Section 23

Altitude at well 300 ft.

TYPE OF WELL: drilled Date Constructed 6/7/54

Depth drilled 24 ft. Depth cased 24 ft.

CASING RECORD: 10 inch

FINISH:

AQUIFERS:

WATER LEVEL: 12 ft.

PUMPING EQUIPMENT: Type Fairbanks Morse centrifugal H.P. 5  
Capacity 200 G.P.M.

WELL TESTS:  
Drawdown 4 ft. after \_\_\_\_\_ hours 250 G.P.M.  
Drawdown \_\_\_\_\_ ft. after \_\_\_\_\_ hours \_\_\_\_\_ G.P.M.

USE OF WATER irrigation 10.5 acres Temp. \_\_\_\_\_ °F. \_\_\_\_\_, 19\_\_\_\_

SOURCE OF INFORMATION GR-531

DRILLER or DIGGER Bill Hamilton Drilling Co.; Albany, Oregon

ADDITIONAL DATA:

Log \_\_\_\_\_ Water Level Measurements \_\_\_\_\_ Chemical Analysis \_\_\_\_\_ Aquifer Test \_\_\_\_\_

REMARKS: