

LINN  
6806

# Well Record

OWNER: Hiram & Sadie Gregson


MAILING ADDRESS: Rt. 2, Box 242

LOCATION OF WELL: Owner's No. 2

CITY AND STATE: Lebanon, Oregon

SE 1/4 SE 1/4 Sec. 23 T. 11 N. S. R. 2 E. W., W.M.

Bearing and distance from section or subdivision  
corner N. 68° E. 35.5 chs. from SW cor. SE 1/4 Sec. 23

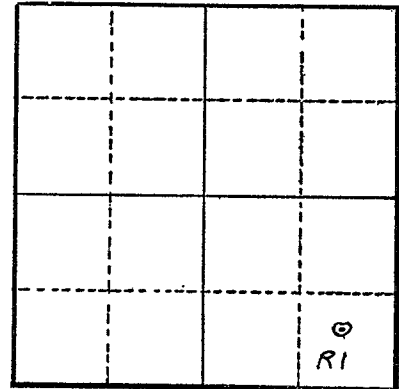

Section 23

Altitude at well 300

TYPE OF WELL: drilled Date Constructed 10/12/54

Depth drilled 24 ft. Depth cased 24 ft.

CASING RECORD: 10 in.

FINISH:

AQUIFERS:

WATER LEVEL: 12 ft.

PUMPING EQUIPMENT: Type Fairbanks Morse centrifugal H.P. tractor  
Capacity 200 G.P.M.

WELL TESTS:

Drawdown 4 ft. after \_\_\_\_\_ hours \_\_\_\_\_ 250 G.P.M.

Drawdown \_\_\_\_\_ ft. after \_\_\_\_\_ hours \_\_\_\_\_ G.P.M.

USE OF WATER irrigation 11.8 acres Temp. \_\_\_\_\_ °F. \_\_\_\_\_, 19

SOURCE OF INFORMATION GR-532

DRILLER or DIGGER Bill Hamilton Drilling Co.; Albany, Oregon

ADDITIONAL DATA:

Log \_\_\_\_\_ Water Level Measurements \_\_\_\_\_ Chemical Analysis \_\_\_\_\_ Aquifer Test \_\_\_\_\_

REMARKS: