

STATE ENGINEER
Salem, Oregon

LINN
6815

Well Record

STATE WELL NO. 11/2W-24Q
COUNTY Linn
APPLICATION NO. GR-948

OWNER: George W. & Katie E. Call

MAILING ADDRESS: Rt. 3, Box 76

LOCATION OF WELL: Owner's No. _____

CITY AND STATE: Lebanon, Oregon


SW $\frac{1}{4}$ SE $\frac{1}{4}$ Sec. 24 T. 11 ^{N.} S., R. 2 ^{E.} W., W.M.

Bearing and distance from section or subdivision corner _____

Altitude at well 312 ft.

TYPE OF WELL: drilled Date Constructed Apr. 1951

Depth drilled 22 ft. Depth cased 22 ft.

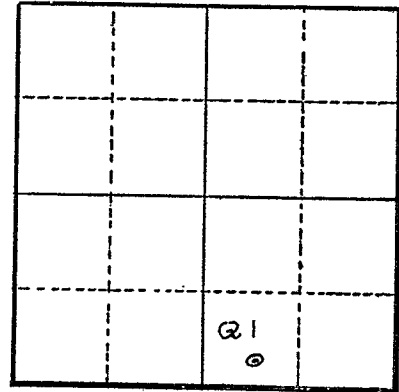

Section 24

CASING RECORD: 4" diameter steel casing from 0 to 22 ft.

FINISH: Slot perforations from 16 to 22 ft.

AQUIFERS: _____

WATER LEVEL: 8 ft.

PUMPING EQUIPMENT: Type 3 in. centrifugal H.P. 20 elec.
Capacity 500 G.P.M.

WELL TESTS:
Drawdown 12 ft. after _____ hours 500 G.P.M.
Drawdown _____ ft. after _____ hours _____ G.P.M.

USE OF WATER irrigation Temp. _____ °F. _____, 19____

SOURCE OF INFORMATION owner

DRILLER or DIGGER _____

ADDITIONAL DATA:
Log _____ Water Level Measurements _____ Chemical Analysis _____ Aquifer Test _____

REMARKS: _____