

STATE ENGINEER
Salem, Oregon

LINN
6855

Well Record


STATE WELL NO. 11/2W - 260
COUNTY LINN
APPLICATION NO. GR-2292

OWNER: Frank M. and Josephine B. Shores MAILING ADDRESS: Rt. 2, Box 243 B,

LOCATION OF WELL: Owner's No. _____ CITY AND STATE: Lebanon, Oregon

NE 1/4 NW 1/4 Sec. 26 T. 11 S., R. 2 W., W.M.

Bearing and distance from section or subdivision corner 1370' N. and 2270' E. of NW corner of DLC 57

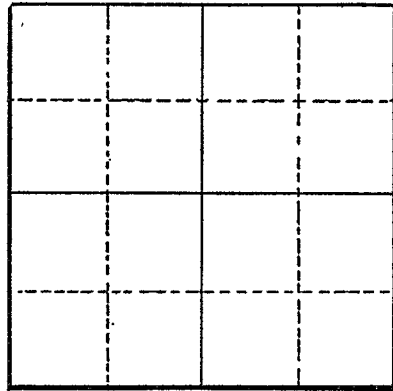

Section _____

Altitude at well _____

TYPE OF WELL: Dug Date Constructed 1952

Depth drilled 15' Depth cased 15'

CASING RECORD:

3' X 3'

FINISH:

Wood casing from 0 to 15

AQUIFERS:

Not available

WATER LEVEL:

11-feet

PUMPING EQUIPMENT: Type Gould Centrifugal 3" - 1 1/4" H.P. 3
Capacity 90 G.P.M.

WELL TESTS:

Drawdown _____ ft. after _____ hours _____ G.P.M.
Drawdown _____ ft. after _____ hours _____ G.P.M.

USE OF WATER Irrigation Temp. _____ °F. _____, 19____

SOURCE OF INFORMATION GR-2187

DRILLER or DIGGER Lonnie Melson, Lebanon, Oregon

ADDITIONAL DATA:

Log _____ Water Level Measurements _____ Chemical Analysis _____ Aquifer Test _____

REMARKS:

Not available