

STATE ENGINEER  
Salem, Oregon

LINN  
6856

# Well Record

STATE WELL NO. 11/2W-26 C  
COUNTY Linn  
APPLICATION NO. GR-933

OWNER: Curtis J./Thelma M. Spires


MAILING ADDRESS: Rt. 2, Box 243 F

LOCATION OF WELL: Owner's No.

CITY AND STATE: Lebanon, Oregon

NE 1/4 NW 1/4 Sec. 26 T. 11 N. S., R. 2 E. W., W.M.

Bearing and distance from section or subdivision corner

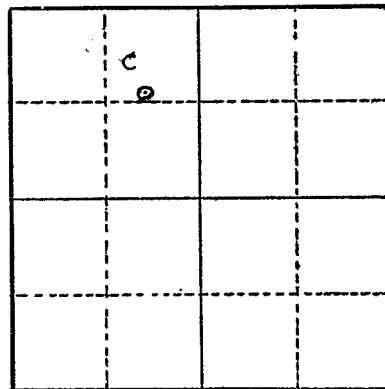

Section 26

Altitude at well 300 ft.

TYPE OF WELL: sump Date Constructed June 1955

Depth drilled 18 ft. Depth cased

### CASING RECORD:

FINISH: Dug pit 25" x 36"

AQUIFERS: Gravel 15 to 18 ft.

WATER LEVEL: 10 ft.

PUMPING EQUIPMENT: Type 1 1/4" centrifugal H.P. 2 elec.  
Capacity 100 G.P.M.

WELL TESTS:  
Drawdown 2 ft. after (est.) hours 200 G.P.M.  
Drawdown ft. after hours G.P.M.

USE OF WATER irrigation Temp. °F. 19

SOURCE OF INFORMATION owner

DRILLER or DIGGER Floyd Graham Const. Co.; Lebanon, Oregon

### ADDITIONAL DATA:

Log  Water Level Measurements Chemical Analysis Aquifer Test

REMARKS: Log: Soil & gravel 0 to 3 ft.  
Gravel 3 to 18 ft.