

STATE ENGINEER
Salem, Oregon

LIMN
6857

Well Record

STATE WELL NO. 11/2W-26C
COUNTY Linn
APPLICATION NO. GR-1630

GR- 1595

OWNER: Harry M. & Esther J. Dummert


MAILING ADDRESS: Rt. 2, Box 211A

LOCATION OF WELL: Owner's No. _____

CITY AND STATE: Lebanon, Oregon

NE 1/4 NW 1/4 Sec. 26 T. 11 S., R. 2 W., W.M.

Bearing and distance from section or subdivision corner 1155' S. & 1386' E. from NW cor., Sec. 26

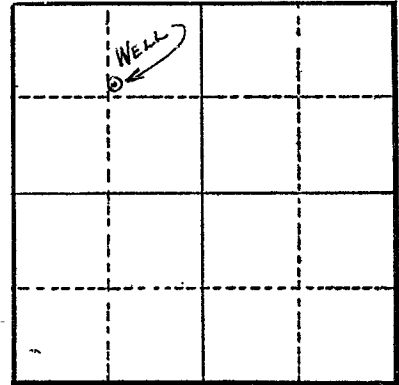

Section 26

Altitude at well 300'

TYPE OF WELL: Drilled Date Constructed 1952

Depth drilled 23' Depth cased 23'

CASING RECORD:

6"

FINISH:

Slot perforations from 15 to 23 ft.

AQUIFERS:

WATER LEVEL:

10'

PUMPING EQUIPMENT: Type Goulds 1 1/4" Cent. H.P. 2

Capacity 100 G.P.M.

WELL TESTS:

Drawdown _____ ft. after _____ hours _____ G.P.M.

Drawdown _____ ft. after _____ hours _____ G.P.M.

USE OF WATER Irrigation Temp. _____ °F. _____, 19_____

SOURCE OF INFORMATION GR Record

DRILLER or DIGGER McLain & Son

ADDITIONAL DATA:

Log N.A. Water Level Measurements _____ Chemical Analysis _____ Aquifer Test _____

REMARKS:

Irrigation of 1.7 acres.