

LINN  
6858


# Well Record

OWNER: Max, Elizabeth & Clara Burkhardt MAILING ADDRESS: Rt. 2, Box 216

LOCATION OF WELL: Owner's No. 2 CITY AND STATE: Lebanon, Oregon

NE 1/4 NW 1/4 Sec. 26 T. 11 S., R. 2 W., W.M.

Bearing and distance from section or subdivision corner 50.37 chs. N. 78° 11' E. from NW cor. DIC 57

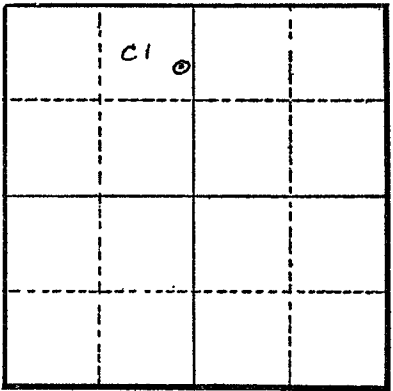

Section 26

Altitude at well 302 ft. Interpolated

TYPE OF WELL: drilled Date Constructed 11/3/50

Depth drilled 25 ft. Depth cased 25 ft.

CASING RECORD: 8 in. steel casing set from 0 to 25 ft.

FINISH: Perforated 0 to 25 ft.

AQUIFERS: no record

WATER LEVEL: 10 ft. below land surface

PUMPING EQUIPMENT: Type Fairbanks Morse centrifugal 3" H.P. 20  
Capacity 600 G.P.M.

WELL TESTS:  
Drawdown 2 ft. after \_\_\_\_\_ hours pumping 700 G.P.M.  
Drawdown \_\_\_\_\_ ft. after \_\_\_\_\_ hours \_\_\_\_\_ G.P.M.

USE OF WATER irrigation 78 acres Temp. \_\_\_\_\_ °F., 19

SOURCE OF INFORMATION Reg. St. GR-161

DRILLER or DIGGER Rosco West; Salem, Oregon

ADDITIONAL DATA:  
Log \_\_\_\_\_ Water Level Measurements \_\_\_\_\_ Chemical Analysis \_\_\_\_\_ Aquifer Test \_\_\_\_\_

REMARKS: