

STATE ENGINEER  
Salem, Oregon

LINA  
6862

# Well Record


STATE WELL NO. 11/2W-26E(1)  
COUNTY Linn  
APPLICATION NO. GR-161

OWNER: Max, Elizabeth & Clara Burkhart MAILING ADDRESS: Rt. 2, Box 216

LOCATION OF WELL: Owner's No. 3 CITY AND STATE: Lebanon, Oregon

SW 1/4 NW 1/4 Sec. 26 T. 11 N. S. R. 2 W., W.M.

Bearing and distance from section or subdivision corner 18.15 chs. S. 38° 15' E. from NW cor. DLC 57

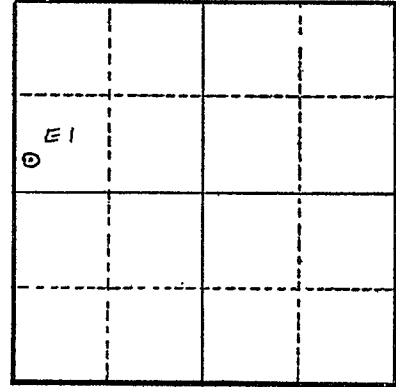

Section 26

Altitude at well 300 ft. Interpolated

TYPE OF WELL: drilled Date Constructed 3/3/50

Depth drilled 30 ft. Depth cased 30 ft.

CASING RECORD: 10 inch steel casing set from 0 to 30 ft.

FINISH: Perforated for 30 ft.

AQUIFERS: no record

WATER LEVEL: 12 ft. below land surface

PUMPING EQUIPMENT: Type Fairbanks Morse 3" centrifugal H.P. 15  
Capacity 600 G.P.M.

WELL TESTS:  
Drawdown 3 ft. after \_\_\_\_\_ hours pumping 700 G.P.M.  
Drawdown \_\_\_\_\_ ft. after \_\_\_\_\_ hours \_\_\_\_\_ G.P.M.

USE OF WATER irrigation 39.5 acres Temp. \_\_\_\_\_ °F., 19

SOURCE OF INFORMATION Reg. St. GR-161

DRILLER or DIGGER Roscoe West; Salem, Oregon

ADDITIONAL DATA:

Log \_\_\_\_\_ Water Level Measurements \_\_\_\_\_ Chemical Analysis \_\_\_\_\_ Aquifer Test \_\_\_\_\_

REMARKS: