

STATE ENGINEER
Salem, Oregon

LINN
6863

OBSERVATION WELL
Well Record

STATE WELL NO. 11/2W-26E
COUNTY Linn
APPLICATION NO. GR-1585

GR- 1533

OWNER: Marvin & Mignon Ufford


MAILING ADDRESS: Rt. 2, Box 209

LOCATION OF WELL: Owner's No.

CITY AND STATE: Lebanon, Oregon

SE 1/4 NW 1/4 Sec. 26 T. 11 S., R. 2 W., W.M.

Bearing and distance from section or subdivision corner S. 71° 50' W. 31.75 ch. from NE cor. D.L.C. #57

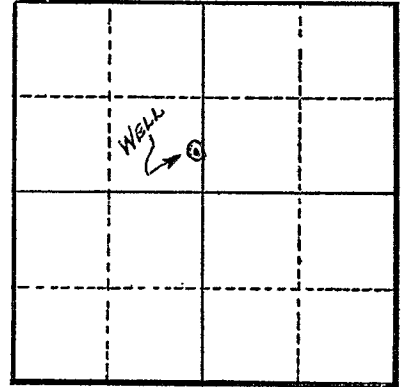

Section 26

Altitude at well 305'

TYPE OF WELL: Drilled Date Constructed 1942

Depth drilled 20' Depth cased 20'

CASING RECORD:

8"

FINISH:

Slot perforations from 12 to 20 ft.

AQUIFERS:

WATER LEVEL:

10'

PUMPING EQUIPMENT: Type Cornell 2 1/2" Cent. H.P. 15
Capacity 350 G.P.M.

WELL TESTS:

Drawdown ft. after hours G.P.M.

Drawdown ft. after hours G.P.M.

USE OF WATER Irrigation Temp. °F., 19

SOURCE OF INFORMATION GR Record

DRILLER or DIGGER Willard Sloper Jr.

ADDITIONAL DATA:

Log N.A. Water Level Measurements Chemical Analysis Aquifer Test

REMARKS:

Irrigation of 52.4 acres.