

STATE ENGINEER  
Salem, Oregon

LINN  
6864

# Well Record

STATE WELL NO. 11/2W-26G(1)  
COUNTY Linn  
APPLICATION NO. GR-260

OWNER: Myrtle Donovan


MAILING ADDRESS: Rt. 2, Box 207 A

LOCATION OF WELL: Owner's No. 1

CITY AND STATE: Lebanon, Oregon

SW 1/4 NE 1/4 Sec. 26 T. 11 N. S. R. 2 W., W.M.

Bearing and distance from section or subdivision corner S. 45° 30' W. 14.5 chs. from NE cor. S.M. Pennington DLC 57

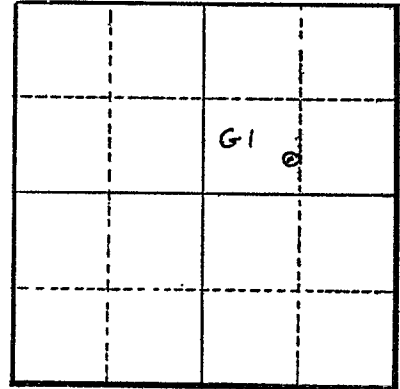

Section 26

Altitude at well 307 ft. Interpolated

TYPE OF WELL: drilled Date Constructed 1943

Depth drilled 25 ft. Depth cased 25 ft.

CASING RECORD: 8 in. steel casing set from 0 to 25 ft.

FINISH: Perforations - slits set from 20 to 25 ft.

AQUIFERS: unknown

WATER LEVEL: 8 ft. below land surface

PUMPING EQUIPMENT: Type Fairbanks Morse 3" centrifugal H.P. 10  
Capacity 300 G.P.M.

WELL TESTS:  
Drawdown 1 ft. after \_\_\_\_\_ hours pumping 200 G.P.M.  
Drawdown \_\_\_\_\_ ft. after \_\_\_\_\_ hours \_\_\_\_\_ G.P.M.

USE OF WATER irrigation 21.8 acres Temp. \_\_\_\_\_ °F. 19

SOURCE OF INFORMATION Reg. St. GR-260

DRILLER or DIGGER \_\_\_\_\_

ADDITIONAL DATA:

Log \_\_\_\_\_ Water Level Measurements \_\_\_\_\_ Chemical Analysis \_\_\_\_\_ Aquifer Test \_\_\_\_\_

REMARKS: