

STATE ENGINEER  
Salem, Oregon

LINN  
6865

# Well Record

STATE WELL NO. 11/2W-26H  
COUNTY Linn  
APPLICATION NO. GR-3417

OWNER: Loren W. and Helen J. Blacklaw


MAILING ADDRESS: Route 2, Box 205

LOCATION OF WELL: Owner's No. Well #2

CITY AND STATE: Lebanon, Oregon

SE 1/4 NE 1/4 Sec. 26 T. 11 N. S, R. 2 E. W., W.M.

Bearing and distance from section or subdivision corner S 8° 10' E. 9.5 chains from NE Corn. of DLC 57

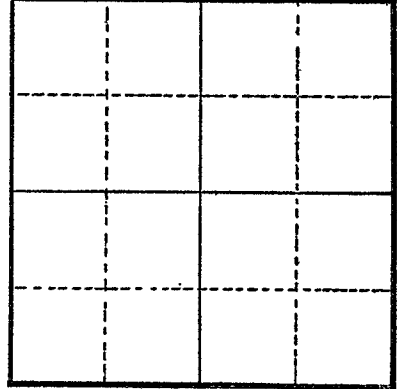

Section .....

Altitude at well .....

TYPE OF WELL: drilled Date Constructed 1950

Depth drilled 25' Depth cased 75'

CASING RECORD:

10"

FINISH:

slot perforations

from 19 to 25

AQUIFERS:

WATER LEVEL:

15'

PUMPING EQUIPMENT: Type Fairbanks Morse 3" Cent. H.P. 15  
Capacity 300 G.P.M.

WELL TESTS:

Drawdown 3 ft. after ..... hours pumping 500 G.P.M.  
Drawdown ..... ft. after ..... hours ..... G.P.M.

USE OF WATER Irrigation Temp. °F. ...., 19

SOURCE OF INFORMATION GR-3163

DRILLER or DIGGER Bill Hamilton Drilling Co.

ADDITIONAL DATA:

Log ..... Water Level Measurements ..... Chemical Analysis ..... Aquifer Test .....

REMARKS: