

STATE ENGINEER  
Salem, Oregon

LINN  
6866

# Well Record

STATE WELL NO. 11/2W-26H  
COUNTY LINN  
APPLICATION NO. GR-2787

OWNER: James O. and Eva Andrews


MAILING ADDRESS: 1707 Main St.,

LOCATION OF WELL: Owner's No.

CITY AND STATE: Lebanon, Oregon

SE 1/4 NE 1/4 Sec. 26 T. 11 N. S. R. 2 E. W., W.M.

Bearing and distance from section or subdivision corner 1782' S. and 4092' E.

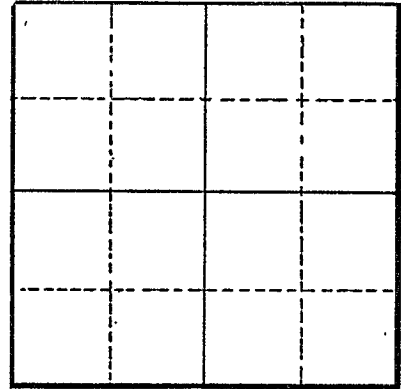

Section

Altitude at well

TYPE OF WELL: drilled Date Constructed 1952

Depth drilled 20 Depth cased

### CASING RECORD:

6-inch

### FINISH:

### AQUIFERS:

### WATER LEVEL:

14-feet

PUMPING EQUIPMENT: Type Fairbanks Morse Centrifugal H.P. 2  
Capacity G.P.M.

### WELL TESTS:

Drawdown ft. after hours G.P.M.  
Drawdown ft. after hours G.P.M.

USE OF WATER irrigation Temp. °F. 19

SOURCE OF INFORMATION GR-2634  
DRILLER or DIGGER Bill Hamilton, Albany, Oregon

### ADDITIONAL DATA:

Log Water Level Measurements Chemical Analysis Aquifer Test

### REMARKS: