

STATE ENGINEER
Salem, Oregon

LINN
6867

Well Record

STATE WELL NO. 11/2W-26J
COUNTY Linn
APPLICATION NO. GR-3419

OWNER: Mrs. Mary Blacklaw


MAILING ADDRESS: 244 Poplar St.

LOCATION OF WELL: Owner's No. Well #1

CITY AND STATE: Walla Walla, Washington

NE 1/4 SE 1/4 Sec. 26 T. 11 N. S., R. 2 E. W., W.M.

Bearing and distance from section or subdivision corner 5° 40' E 29.5 chains from NE Cor. DLG 57

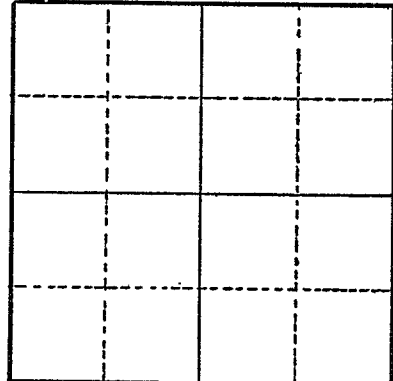

Section

Altitude at well

TYPE OF WELL: drilled Date Constructed 1952

Depth drilled 25' Depth cased 25'

CASING RECORD:

10"

FINISH:

slot perforations from 19 to 25

AQUIFERS:

WATER LEVEL:

15'

PUMPING EQUIPMENT: Type Jacuzzi Turbine H.P. 25

Capacity 750 G.P.M.

WELL TESTS:

Drawdown 4 ft. after hours pumping 1000 G.P.M.

Drawdown ft. after hours G.P.M.

USE OF WATER Irrigation Temp. °F. 19

SOURCE OF INFORMATION GR-3165

DRILLER or DIGGER Bill Hamilton Drilling Co., 838 East 3rd Avenue, Albany, Oregon

ADDITIONAL DATA:

Log Water Level Measurements Chemical Analysis Aquifer Test

REMARKS: