

STATE ENGINEER  
Salem, Oregon

LINN  
6868

# Well Record

STATE WELL NO. 11/2W-26J  
COUNTY Linn  
APPLICATION NO. GR-3416

OWNER: Loren W. and Helen J. Blacklaw


MAILING ADDRESS: Route 2, Box 205

LOCATION OF WELL: Owner's No. Well #1

CITY AND STATE: Lebanon, Oregon

NE 1/4 SE 1/4 Sec. 26 T. 11 N. S., R. 2 E. W., W.M.

Bearing and distance from section or subdivision corner S. 3° 10' W. 27 chains from the NE Corn. of DLC 57

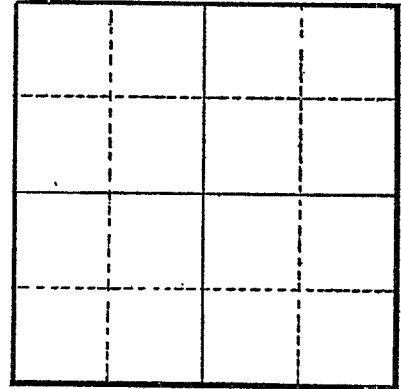

Section

Altitude at well

TYPE OF WELL: drilled Date Constructed 1952

Depth drilled 25' Depth cased 25'

CASING RECORD:

10"

FINISH:

slot perforations from 19 to 25

AQUIFERS:

WATER LEVEL:

15'

PUMPING EQUIPMENT: Type 2 1/2" Centrifugal H.P. 10  
Capacity 300 G.P.M.

WELL TESTS:

Drawdown 4 ft. after hours pumping 350 G.P.M.

Drawdown ft. after hours G.P.M.

USE OF WATER Irrigation Temp. °F. 19

SOURCE OF INFORMATION GR-3162

DRILLER or DIGGER Bill Hamilton Drilling Co. 838 East Third Ave. Albany, Oregon

ADDITIONAL DATA:

Log Water Level Measurements Chemical Analysis Aquifer Test

REMARKS: