

STATE ENGINEER
Salem, Oregon

LINN
6886

Well Record

STATE WELL NO. 11/2W-27H
COUNTY LINN
APPLICATION NO. GR-2771

OWNER: Fred and Margaret J. Hageman


MAILING ADDRESS: Rt. 2, Box 216F

LOCATION OF WELL: Owner's No.

CITY AND STATE: Lebanon, Oregon

SE 1/4 NE 1/4 Sec. 27 T. 11 N. S., R. 2 E. W., W.M.

Bearing and distance from section or subdivision corner 1452' S. and 396' W.

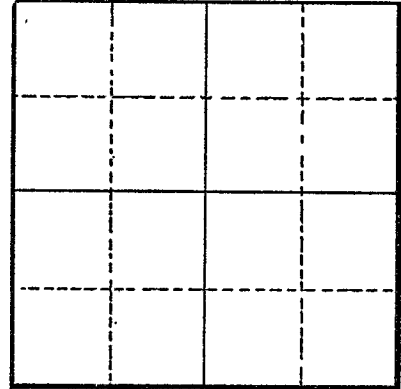

Section

Altitude at well

TYPE OF WELL: drilled Date Constructed 1955

Depth drilled 26 Depth cased 26

CASING RECORD:

10-inch

FINISH:

Slot perforations from 14 to 26

AQUIFERS:

WATER LEVEL:

13-feet

PUMPING EQUIPMENT: Type Meyers Centrifugal H.P. 5
Capacity 150 G.P.M.

WELL TESTS:

Drawdown ft. after hours G.P.M.
Drawdown ft. after hours G.P.M.

USE OF WATER irrigation Temp. °F. 19

SOURCE OF INFORMATION GR-2620

DRILLER or DIGGER Bill Hamilton Drilling Co., 838 E. Third Ave., Albany, Oregon

ADDITIONAL DATA:

Log Water Level Measurements Chemical Analysis Aquifer Test

REMARKS: