

STATE ENGINEER
Salem, Oregon

LINN
6910

Well Record

STATE WELL NO. 11/2W-30A
COUNTY LINN
APPLICATION NO. GR. 2406

OWNER: Robert V. Cox

MAILING ADDRESS: Rt. 2, Box 255.


LOCATION OF WELL: Owner's No.

CITY AND STATE: Lebanon, Oregon

NE 1/4 NE 1/4 Sec. 30 T. 11 S. R. 2 W., W.M.

Bearing and distance from section or subdivision

corner 891' S. and 1122' W.

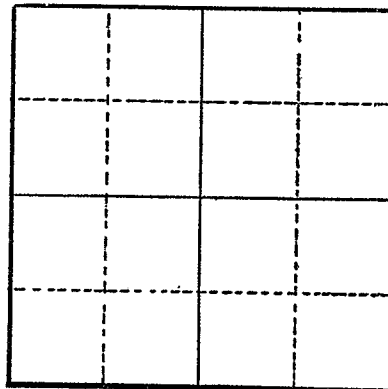

Section

Altitude at well

TYPE OF WELL: Drilled Date Constructed 1953

Depth drilled 138 Depth cased 138

CASING RECORD:

8-inch

FINISH:

Slot perforations from 104 to 107
Slot perforations from 118 to 138

AQUIFERS:

WATER LEVEL:

8-feet

PUMPING EQUIPMENT: Type Stayrite deep well Turbine H.P. 20
Capacity 250 G.P.M.

WELL TESTS:

Drawdown 100 ft. after hours Pumping 200 G.P.M.

Drawdown ft. after hours G.P.M.

USE OF WATER Irrigation Temp. °F. 19

SOURCE OF INFORMATION GR. 2287

DRILLER or DIGGER Cy. Burkhardt (address unknown)

ADDITIONAL DATA:

Log Water Level Measurements Chemical Analysis Aquifer Test

REMARKS: