

STATE ENGINEER
Salem, Oregon

LINN
6911


Well Record

STATE WELL NO. 11/2W-30E
COUNTY Linn
APPLICATION NO. CR-3242

OWNER: Nicholas and/or Olga B. VandenBos MAILING ADDRESS: Route 2, Box 252
LOCATION OF WELL: Owner's No. _____ CITY AND STATE: Lebanon, Oregon

SW 1/4 NW 1/4 Sec. 30 T. 11 S., R. 2 W., W.M.

Bearing and distance from section or subdivision corner 3168' N. and 462' E. of S.W. corner of Sec. 11

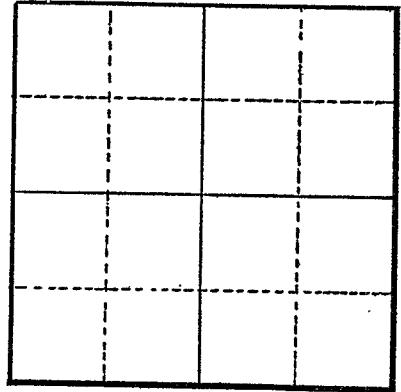

Section _____

Altitude at well _____

TYPE OF WELL: dug Date Constructed 1946

Depth drilled 8 Depth cased 8

CASING RECORD:

4' x 4'

FINISH:

Wooden curbing

AQUIFERS:

WATER LEVEL:

PUMPING EQUIPMENT: Type Fairbank Morse Centrifugal H.P. 10
Capacity _____ G.P.M.

WELL TESTS:

Drawdown _____ ft. after _____ hours _____ G.P.M.
Drawdown _____ ft. after _____ hours _____ G.P.M.

USE OF WATER Irrigation Temp. _____ °F., 19 _____

SOURCE OF INFORMATION CR-3017

DRILLER or DIGGER _____

ADDITIONAL DATA:

Log _____ Water Level Measurements _____ Chemical Analysis _____ Aquifer Test _____

REMARKS: