

STATE ENGINEER
Salem, Oregon

LINN
6962

Well Record

STATE WELL NO. 11/2W-34G
COUNTY LINN
APPLICATION NO. GR-2670

OWNER: Ira Beckler

MAILING ADDRESS:

Rt. 2, Box 183 A,

LOCATION OF WELL: Owner's No. _____


CITY AND STATE:

Lebanon, Oregon

SW 1/4 NE 1/4 Sec. 34 T. 11 N. S., R. 2 E. W., W.M.

Bearing and distance from section or subdivision

corner 2673' E. and 1353' S.

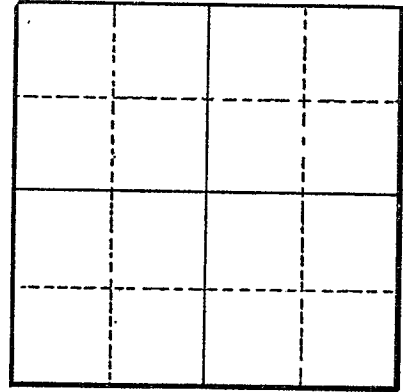

Section _____

Altitude at well _____

TYPE OF WELL: drilled Date Constructed 1953

Depth drilled 60 Depth cased 50

CASING RECORD:

6-inch

FINISH:

Slot perforations from 40 to 50

AQUIFERS:

WATER LEVEL:

15-feet

PUMPING EQUIPMENT: Type Centrifugal

H.P. 5

Capacity 100 G.P.M.

WELL TESTS:

Drawdown _____ ft. after _____ hours _____ G.P.M.

Drawdown _____ ft. after _____ hours _____ G.P.M.

USE OF WATER Irrigation

Temp. _____ °F., 19_____

SOURCE OF INFORMATION GR-2532

DRILLER or DIGGER _____

ADDITIONAL DATA:

Log _____ Water Level Measurements _____ Chemical Analysis _____ Aquifer Test _____

REMARKS: