

STATE ENGINEER
Salem, Oregon

21NN
6964

Well Record

GR- 1624

STATE WELL NO. 11/2W-34P
COUNTY Linn
APPLICATION NO. GR- 1674

OWNER: C. M. & Ella Bryant


MAILING ADDRESS: Rt. 2, Box 180

LOCATION OF WELL: Owner's No. _____

CITY AND STATE: Lebanon, Oregon

SE ¼ SW ¼ Sec. 34 T. 11 ^{XX} S., R. 2 ^{XX} W., W.M.

Bearing and distance from section or subdivision
corner 50.25 ch. S.77°W. from NE cor. of John H.
Settle DLG #65

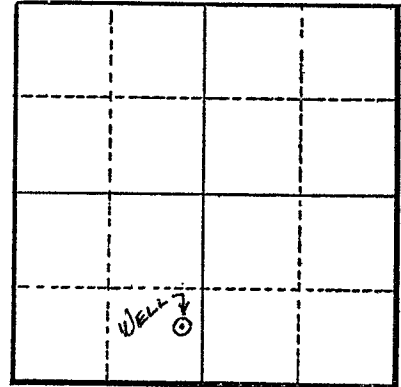

Section 34

Altitude at well 325'

TYPE OF WELL: Drilled Date Constructed 1954

Depth drilled 118' Depth cased 118'

CASING RECORD:

6"

FINISH:

Slot perforations from 65 to 118 ft.

AQUIFERS:

WATER LEVEL:

10'

PUMPING EQUIPMENT: Type F. M. 4" Cent. H.P. 15
Capacity 180 G.P.M.

WELL TESTS:

Drawdown 50 ft. after _____ hours 220 G.P.M.

Drawdown _____ ft. after _____ hours _____ G.P.M.

USE OF WATER Irrigation Temp. _____ °F. _____, 19____

SOURCE OF INFORMATION GR Record

DRILLER or DIGGER Bob White

ADDITIONAL DATA:

Log N.A. Water Level Measurements _____ Chemical Analysis _____ Aquifer Test _____

REMARKS:

Irrigation of 30 acres.