

STATE ENGINEER  
Salem, Oregon

*LINN*  
*6965*

# Well Record

STATE WELL NO. 11/2W-34R  
COUNTY Linn  
APPLICATION NO. GR-3450

OWNER: William M. Mitchell


MAILING ADDRESS: Route 2, Box 183

LOCATION OF WELL: Owner's No. \_\_\_\_\_

CITY AND STATE: Lebanon, Oregon

SE  $\frac{1}{4}$  SE  $\frac{1}{4}$  Sec. 34 T. 11 <sup>N.</sup> S., R. 2 <sup>E.</sup> W., W.M.

Bearing and distance from section or subdivision corner N. 18°30' W. 7.5 chains from SE. Cor.

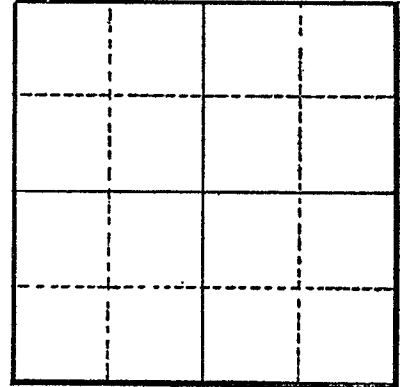

Section \_\_\_\_\_

Altitude at well \_\_\_\_\_

TYPE OF WELL: drilled Date Constructed 1952

Depth drilled 108' Depth cased 108'

### CASING RECORD:

8"

### FINISH:

slot perforations from 12 to 50  
slot perforations from 90 to 108

### AQUIFERS:

### WATER LEVEL:

15'

PUMPING EQUIPMENT: Type Gould 2 $\frac{1}{2}$ " Cent. H.P. 10  
Capacity 350 G.P.M.

### WELL TESTS:

Drawdown \_\_\_\_\_ ft. after \_\_\_\_\_ hours \_\_\_\_\_ G.P.M.  
Drawdown \_\_\_\_\_ ft. after \_\_\_\_\_ hours \_\_\_\_\_ G.P.M.

USE OF WATER Irrigation Temp. \_\_\_\_\_ °F., 19 \_\_\_\_\_

SOURCE OF INFORMATION GR-3191

DRILLER or DIGGER Marion West Salem, Oregon

### ADDITIONAL DATA:

Log \_\_\_\_\_ Water Level Measurements \_\_\_\_\_ Chemical Analysis \_\_\_\_\_ Aquifer Test \_\_\_\_\_

### REMARKS: