

STATE ENGINEER  
Salem, Oregon

LINN  
6994

# Well Record

STATE WELL NO. 11/2W-35B  
COUNTY LINN  
APPLICATION NO. GR-2390

OWNER: Edward and Joan Douglas


MAILING ADDRESS: Rt. 2, Box 194, Lebanon, Oregon

LOCATION OF WELL: Owner's No.

CITY AND STATE: Lebanon, Oregon

NW 1/4 NE 1/4 Sec. 35 T. 11 S. R. 2 W., W.M.

Bearing and distance from section or subdivision corner N. 45° 15' W. 28.2 chains from SE corner D.L.C. 57

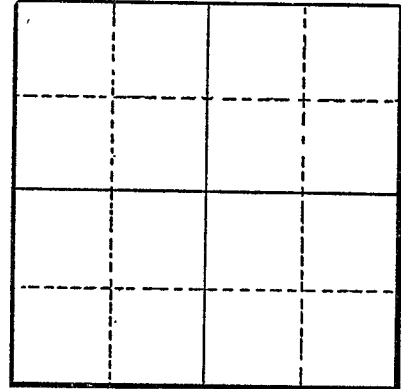

Section

Altitude at well

TYPE OF WELL: Drilled Date Constructed 1952

Depth drilled 26 Depth cased 26

### CASING RECORD:

10-inch

### FINISH:

Slotted perforations from 16 to 26

### AQUIFERS:

### WATER LEVEL:

14-feet

PUMPING EQUIPMENT: Type Gould 3" Centrifugal H.P. 20  
Capacity 480 G.P.M.

### WELL TESTS:

Drawdown 16 1/2 ft. after hours Pumping 500 G.P.M.  
Drawdown ft. after hours G.P.M.

USE OF WATER Irrigation Temp. °F., 19

SOURCE OF INFORMATION GR-2271

DRILLER or DIGGER Bill Hamilton Drilling Co., 838 E. Third Ave., Albany, Oregon

### ADDITIONAL DATA:

Log Water Level Measurements Chemical Analysis Aquifer Test

### REMARKS: