

STATE ENGINEER
Salem, Oregon

LINN
6995

Well Record

STATE WELL NO. 11/2W-35C
COUNTY Linn
APPLICATION NO. GR-3040

OWNER: George H. Meyer

MAILING

ADDRESS: Route 1, Box 190-F

LOCATION OF WELL: Owner's No. _____

CITY AND


STATE: Lebanon, Oregon

NE 1/4 NW 1/4 Sec. 35 T. 11 S., R. 2 W., W.M.

Bearing and distance from section or subdivision

corner 1980' E. and 1050' S. from N.E. corner

Section 35 Stewart M. Pennington DLC #57

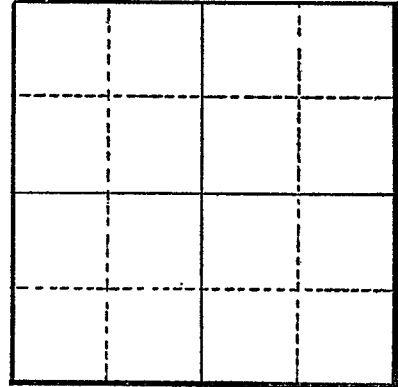

Section _____

Altitude at well _____

TYPE OF WELL: drilled Date Constructed 1952

Depth drilled 45 Depth cased 45

CASING RECORD:

6 inches

FINISH:

from 41 to 45

AQUIFERS:

sand and gravel

WATER LEVEL:

12 feet

PUMPING EQUIPMENT: Type _____

Fairbanks Morse Centrifugal

H.P. 7 1/2

Capacity _____ G.P.M.

WELL TESTS:

2

Drawdown _____ ft. after _____ hours _____ G.P.M.

Drawdown _____ ft. after _____ hours _____ G.P.M.

USE OF WATER Irrigation

Temp. _____ °F., 19 _____

SOURCE OF INFORMATION GR-2846

DRILLER or DIGGER _____

ADDITIONAL DATA:

Log Water Level Measurements _____ Chemical Analysis _____ Aquifer Test _____

REMARKS:

Sand and gravel