

STATE ENGINEER
Salem, Oregon

LINN
6997

Well Record

STATE WELL NO. 11/2W-35E
COUNTY LINN
APPLICATION NO. GR-2531

OWNER: Georgie C. Mitchell


MAILING ADDRESS: Rt. 2, Box 181,

LOCATION OF WELL: Owner's No. #2

CITY AND STATE: Lebanon, Oregon

SW 1/4 NW 1/4 Sec. 35 T. 11 S. R. 2 W., W.M.

Bearing and distance from section or subdivision corner N. 72° 10' E. 14.3 chains

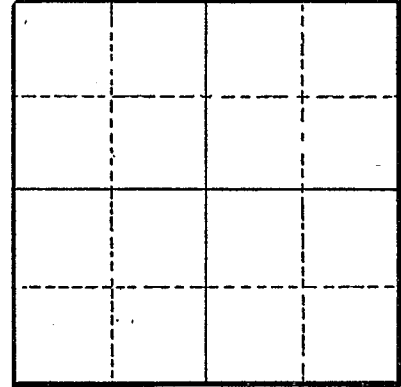

Section

Altitude at well

TYPE OF WELL: Drilled Date Constructed 1951

Depth drilled 32 Depth cased 32

CASING RECORD:

10-inch

FINISH:

Slot perforations from 12 to 32

AQUIFERS:

WATER LEVEL:

14-feet

PUMPING EQUIPMENT: Type Fairbanks Morse 3" Centrifugal H.P. 20
Capacity 500 G.P.M.

WELL TESTS:

Drawdown ft. after hours G.P.M.
Drawdown ft. after hours G.P.M.

USE OF WATER Irrigation Temp. °F. 19

SOURCE OF INFORMATION GR-2393

DRILLER or DIGGER Marion West, Salem, Oregon

ADDITIONAL DATA:

Log Water Level Measurements Chemical Analysis Aquifer Test

REMARKS: