

STATE ENGINEER
Salem, Oregon

LINN
6999

Well Record

GR- 1684

STATE WELL NO. 11/2W-35F
COUNTY Linn
APPLICATION NO. ER-1736

OWNER: A. C. & May Raines


MAILING ADDRESS: Rt. 2, Box 192 A

LOCATION OF WELL: Owner's No. _____

CITY AND STATE: Lebanon, Oregon

SE 1/4 NW 1/4 Sec. 35 T. 11 S., R. 2 W., W.M.

Bearing and distance from section or subdivision corner 501' S. & 2145' E. from NE cor. DIC. #69

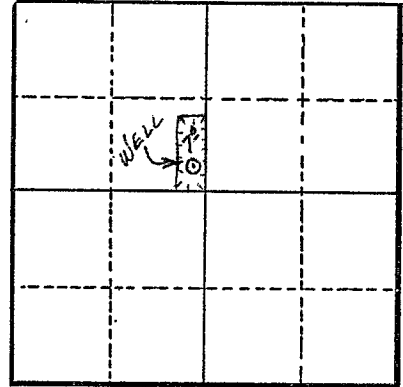

Section 35

Altitude at well 310'

TYPE OF WELL: Drilled Date Constructed 1947

Depth drilled 65' Depth cased 65'

CASING RECORD:

6"

FINISH:

Slot perforations from 20 to 65 ft.

AQUIFERS:

WATER LEVEL:

11'

PUMPING EQUIPMENT: Type A. C. 1 1/2" cent. H.P. 5
Capacity 175 G.P.M.

WELL TESTS:

Drawdown 1 1/2 ft. after JUNE 1948 hours 200 G.P.M.
Drawdown _____ ft. after _____ hours _____ G.P.M.

USE OF WATER Irrigation Temp. _____ °F. _____, 19____

SOURCE OF INFORMATION GR Record

DRILLER or DIGGER Alfred Rucker & Ward Pyle

ADDITIONAL DATA:

Log N.A. Water Level Measurements _____ Chemical Analysis _____ Aquifer Test _____

REMARKS:

Irrigation of 7 acres.