

STATE ENGINEER
Salem, Oregon

LINN
7001

Well Record

STATE WELL NO. 11/2W-35G
COUNTY Linn
APPLICATION NO. GR-1573

GR- 1515

OWNER: John E. C. Freamer


MAILING ADDRESS: Rt. 2, Box 193

LOCATION OF WELL: Owner's No.

CITY AND STATE: Lebanon, Oregon

SW 1/4 NE 1/4 Sec. 35 T. 11 S., R. 2 W., W.M.

Bearing and distance from section or subdivision corner 414' S. & 2529' E. from NW cor. DIC #69

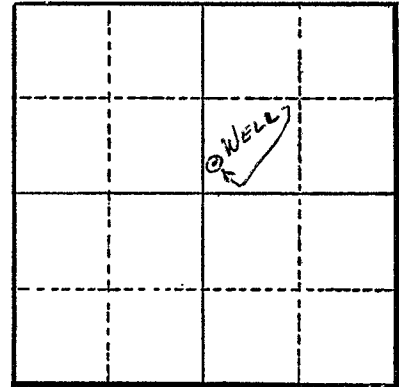

Section 35

Altitude at well 300'

TYPE OF WELL: Drilled Date Constructed 1952

Depth drilled 30' Depth cased 30'

CASING RECORD:

6"

FINISH:

Slot perforations from 15 to 30 ft.

AQUIFERS:

WATER LEVEL:

14'

PUMPING EQUIPMENT: Type Jacuzzi 3" cent. H.P. 5

Capacity 300 G.P.M.

WELL TESTS:

Drawdown .5 ft. after 400 hours G.P.M.

Drawdown ft. after hours G.P.M.

USE OF WATER Irrigation Temp. °F. 19

SOURCE OF INFORMATION GR Record

DRILLER or DIGGER Wade Pyle

ADDITIONAL DATA:

Log N.A. Water Level Measurements Chemical Analysis Aquifer Test

REMARKS:

Irrigation of 8 acres.