

STATE ENGINEER  
Salem, Oregon

LINN  
7005

# Well Record

STATE WELL NO. 11/2W-35K(1)  
COUNTY Linn  
APPLICATION NO. GR-495

OWNER: Charles & Theodore Bicek


MAILING ADDRESS: Rt. 2, Box 117 E

LOCATION OF WELL: Owner's No.

CITY AND STATE: Lebanon, Oregon

NW 1/4 SE 1/4 Sec. 35 T. 11 S., R. 2 W., W.M.

Bearing and distance from section or subdivision corner S. 66° 40' E. 111 chs. from NW cor. DLG 49

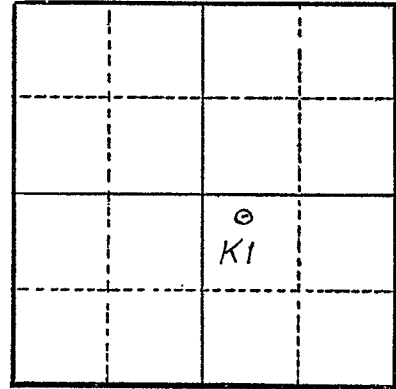

Section 35

Altitude at well 320 ft.

TYPE OF WELL: dug Date Constructed 9/14/53

Depth drilled 25 ft. Depth cased 25 ft.

CASING RECORD: 39 inch

FINISH:

AQUIFERS:

WATER LEVEL: 18 ft.

PUMPING EQUIPMENT: Type Jacuzzi H.P. 5  
Capacity 180 G.P.M.

WELL TESTS:

Drawdown 4 ft. after 200 hours G.P.M.

Drawdown ft. after hours G.P.M.

USE OF WATER irrigation 10 acres Temp. °F., 19

SOURCE OF INFORMATION GR-495

DRILLER or DIGGER C. H. Bicek

ADDITIONAL DATA:

Log <sup>X</sup> Water Level Measurements Chemical Analysis Aquifer Test

REMARKS: