

STATE ENGINEER
Salem, Oregon

LINN
7006

Well Record

STATE WELL NO. 11/2W-35R(1)
COUNTY Linn
APPLICATION NO. GR-281

OWNER: D. H. & Zerma L. Morris

MAILING ADDRESS: Rt. 2, Box 141 A


LOCATION OF WELL: Owner's No. 1

CITY AND STATE: Lebanon, Oregon

SE 1/4 SE 1/4 Sec. 35 T. 11 N. S. R. 2 E. W.M.

Bearing and distance from section or subdivision corner N. 55° 03' E. 41.88 chs. from SW cor.

Andrew Kees DIC 71

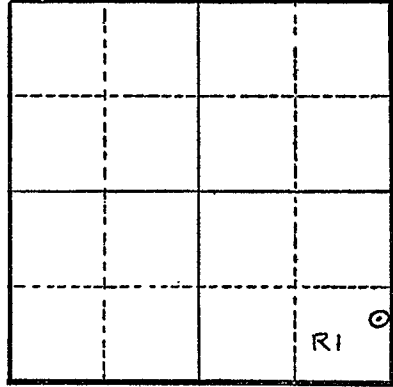

Section 35

Altitude at well 325 ft. Interpolated

TYPE OF WELL: drilled Date Constructed 9/1/51

Depth drilled 45 ft. Depth cased 45 ft.

CASING RECORD: 8 inch steel casing from 0 to 45 ft.

FINISH: Slit perforations set from 30 to 45 ft.

AQUIFERS: unknown

WATER LEVEL: 15 ft. below land surface

PUMPING EQUIPMENT: Type Gould 3" centrifugal H.P. 5
Capacity 125 G.P.M.

WELL TESTS:
Drawdown 5 ft. after _____ hours pumping 200 G.P.M.
Drawdown _____ ft. after _____ hours _____ G.P.M.

USE OF WATER irrigation 11 acres Temp. _____ °F. _____, 19_____

SOURCE OF INFORMATION Reg. St. GR-281

DRILLER or DIGGER Nicholas Klaus; Rt. 4, Albany, Oregon

ADDITIONAL DATA:
Log _____ Water Level Measurements _____ Chemical Analysis _____ Aquifer Test _____

REMARKS: