

LINN
7016

Well Record

OWNER: Charles A. & Wavell Jackson


MAILING ADDRESS:

LOCATION OF WELL: Owner's No.

CITY AND STATE:

NW 1/4 NW 1/4 Sec. 36 T. 11 N. S., R. 2 W., W.M.

Bearing and distance from section or subdivision corner S. 62° 30' E. 5 chs. from NW cor. Sec. 36

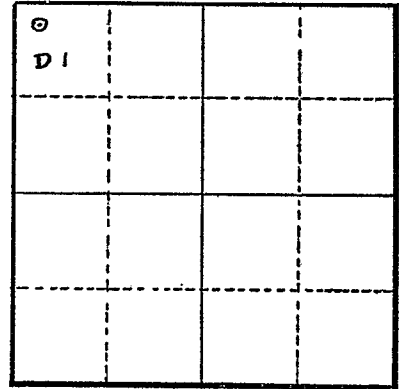

Section 36

Altitude at well 315 ft. Interpolated

TYPE OF WELL: drilled Date Constructed 4/23/53

Depth drilled 23 ft. Depth cased 23 ft.

CASING RECORD: 6 inch steel casing set from 0 to 23 ft.

FINISH: Slit perforations 3/4" x 8" set from 17 to 23 ft.

AQUIFERS: gravels from 2 to 23 ft.

WATER LEVEL: 11 ft. below land surface

PUMPING EQUIPMENT: Type 2 1/2" centrifugal H.P. 3
Capacity 400 G.P.M.

WELL TESTS:
Drawdown 1 ft. after _____ hours pumping 200 G.P.M.
Drawdown _____ ft. after _____ hours _____ G.P.M.

USE OF WATER irrigation 5 acres Temp. _____ °F. 19

SOURCE OF INFORMATION Reg. St. GR-284

DRILLER or DIGGER

ADDITIONAL DATA:

Log Water Level Measurements _____ Chemical Analysis _____ Aquifer Test _____

REMARKS: Log: Topsoil 0 to 2 ft.
Gravel & clay 2 to 16 ft.
coarse gravel 16 to 23 ft.