

STATE ENGINEER
Salem, Oregon

LINN
7017

Well Record

STATE WELL NO. 11/2W-36D
COUNTY Linn
APPLICATION NO. GR-1083

GR- 1401

OWNER: Ethan and/or Edith Hull


MAILING ADDRESS: Rt. 2, Box 199

LOCATION OF WELL: Owner's No.

CITY AND STATE: Lebanon, Oregon

NW 1/4 NW 1/4 Sec. 36 T. 11 S. R. 2 W., W.M.

Bearing and distance from section or subdivision corner S. 41° 40' E. 9.3 ch. from NW cor. Sec. 36

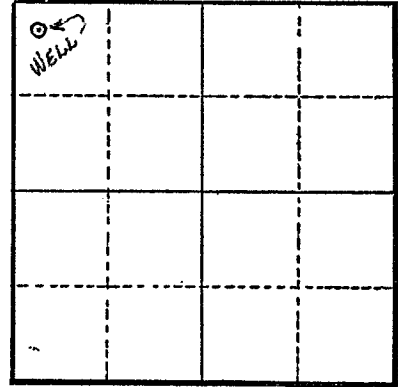

Section 36

Altitude at well 315'

TYPE OF WELL: Drilled Date Constructed 1952

Depth drilled 23' Depth cased 23'

CASING RECORD:

8 inch

FINISH:

Slot perforations from 13' to 23'

AQUIFERS:

WATER LEVEL:

13'

PUMPING EQUIPMENT: Type Goulds 2" Cent. H.P. 15
Capacity 350 G.P.M.

WELL TESTS:

Drawdown 6 ft. after 330 hours G.P.M.

Drawdown ft. after hours G.P.M.

USE OF WATER Irrigation Temp. °F. 19

SOURCE OF INFORMATION GR Record

DRILLER or DIGGER R. C. Gallatly

ADDITIONAL DATA:

Log N.A. Water Level Measurements Chemical Analysis Aquifer Test

REMARKS:

Irrigation of 59 acres.